

SURVEY &
REMONUMENTATION

FEB 18 1994

COMMISSION LAND CORNER RECORDATION CERTIFICATE

Filing Requirement of Act 74, Mich. P.A. 1970

For corners in

<u>KALKASKA</u> <small>(County)</small>	Located In:	Corner Code #
<u>1993 REMONUMENTATION</u>		
1. Public Land Survey	T <u>27N</u> R <u>7W</u>	<u>I-7</u>
	T _____ R _____	_____
	T _____ R _____	_____
	T _____ R _____	_____
2. Property Controlling in Section	S _____ T _____ R _____	_____
	S _____ T _____ R _____	_____
3. Miscellaneous Property in Sec.	S _____ T _____ R _____	_____
	S _____ T _____ R _____	_____

KALKASKA COUNTY, MICHIGAN
RECEIVED

1993 DEC 22 PM 1:32

Joan Hall
REG. OF DEEDS

Register of Deeds Stamp & File Number

4. Lot No. _____, Recorded Plat _____
5. Private Claims _____

A	B	C	D	E	F	G	H	I	J	K	L	M
2	6	5	4	3	2							
3												
4	7	8	9	10	11	12						
5												
6	13	17	16	15	14	13						
7												
8	19	20	21	22	23	24						
9												
10	30	29	28	27	26	25						
11												
12	31	32	33	34	35	36						
13												

I, EUGENE FARRIER, in a field survey on DEC. 8, 19 93, do hereby certify that under requirements of P.A. 74, Michigan P.A. of 1970, the corner points mentioned in lines 1 and 2 above were in conformance with regulations and rules therefore as required in the current manual of survey instructions of the United States Department of the Interior, Bureau of Land Management or by a decree of a Court of Law and/or that the corner points mentioned in lines 3, 4 and 5 above were in conformance with the rules of the Michigan Board of Land Surveyors or by a Decree of a Court of Law; established, re-established, monumented, re-monumented, recovered, found as expressed below:

NOTE: Not more than 4 corners, all in the same town and range, may be recorded on this certificate.

A. Description of original monument and accessories and/or subsequent restoration:


I-7 cor. common to Sec. 14, 15, 22 & 23, T27N-R7W
1850 GLO re-survey: Set Hem post for Corner; Cedar 10" S48W, 10, Cedar 14" N12E, 26.
12-2-59, A.G. Erickson, South Selkirk Shores sub. Liber B, Pg 35 & 36.
6-11-73, J.H. Granger, Set Mon., Liber 1 Pg 801 of Surv.
2-18-73, LCRC Liber 1 Pg 299.
9-29-80, C.F. Roser, D.N.R., fd Conc. Mon. from LCRC.

B. Description of corner evidence found and/or method applied in restoring or reestablishing corner:

I-7 cor. common to Sec. 14, 15, 22 & 23, T27N-R7W
Found Conc. Mon. 1.2' above grd. No strong evidence of GLO ref trees.
On 12-16-93 the Kalkaska Co. peer group approved the above monument as a careful and faithful reestablishment of the position of the original corner.

C. Description of monument for corner and accessories established to perpetuate locating the position of the corner:

I-7 cor. common to Sec. 14, 15, 22 & 23, T27N-R7W
Found Conc. Mon. 1.2' above grd, cemented Aluminum Cap on top of Mon., only fd 2 witnesses, no nails fd in trees, elm was dead & down.
N86E, 38.25', 16" Cedar (fd blaze) set spk
S58W, 10.55', 14" Maple (fd blaze) set spk
N33W, 53.39', 10" Tw. Cedar (set spk - W. fc.)
S12E, 38.63', 10" Cedar (set spk - E. fc.)

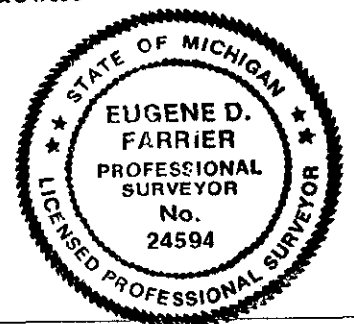

Signed by *Eugene Farrier* Date 12-22
Surveyor's Michigan License No. 24594

FORM 400

MICHIGAN STATE BOARD OF LAND SURVEYORS, JAN. 28, 1971
REVISED MAY 14, 1975
REVISED JAN., 1983