

SURVEY &
REMONUMENTATION

JAN 17 1996

LAND CORNER RECORDATION CERTIFICATE
Filing Requirement of Act 74, Mich. P.A. 1970

For corners in **COMMISSION**

KALKASKA COUNTY, MICHIGAN
RECEIVED

95 DEC 27 AM 9:53

Jan Hall
REG. CLERK

KALKASKA (County)	Located In:	Corner Code #1
1995 REMONUMENTATION		
1. Public Land Survey	T <u>27N</u> R <u>7W</u>	<u>I-12</u>
	T _____ R _____	_____
	T _____ R _____	_____
	T _____ R _____	_____
2. Property Controlling in Section	S _____ T _____ R _____	_____
	S _____ T _____ R _____	_____
3. Miscellaneous Property in Sec.	S _____ T _____ R _____	_____
	S _____ T _____ R _____	_____

Register of Deeds Stamp & File Number

4. Lot No. _____, Recorded Plat _____
5. Private Claims _____

	A	B	C	D	E	F	G	H	I	J	K	L
2	6		5		4		3		2		1	
3												
4	7		8		9		10		11		12	
5												
6	18		17		16		15		14		13	
7												
8	19		20		21		22		23		24	
9												
10	30		29		28		27		26		25	
11												
12	31		32		33		34		35		36	
13												

I, EUGENE FARRIER, in a field survey on Oct. 23, 19 95, do hereby certify that under requirements of P.A. 74, Michigan P.A. of 1970, the corner points mentioned in lines 1 and 2 above were in conformance with regulations and rules therefore as required in the current manual of survey instructions of the United States Department of the Interior, Bureau of Land Management or by a decree of a Court of Law and/or that the corner points mentioned in lines 3, 4 and 5 above were in conformance with the rules of the Michigan Board of Land Surveyors or by a Decree of a Court of Law; established, re-established, monumented, re-monumented, recovered, found as expressed below:

NOTE: Not more than 4 corners, all in the same town and range, may be recorded on this certificate.

A. Description of original monument and accessories and/or subsequent restoration:

I-12: Cor. common to Sec. 34 & 35, T27N-R7W, Kalkaska
1850 GLO re-survey: set 1/4 sec. post, Bech 9", N15W, 33; Bech 8", S20E 17.
8-19-1980, LCRC(J.L.Fletcher), I-12, fd. 1 1/2" sq. stl rod, L.2 PG.216.
2-24-1983, E.D.Farrier, SURVEY, fd. R.R. spike.
2-15-1988, LCRC(B.M.Jones), fd. 1 1/4" sq. iron, L.2 PG.339.
8-11-1990, B.M.Jones, CERT OF SURV, fd. 1 1/4" iron, L.8 PG.440.

B. Description of corner evidence found and/or method applied in restoring or reestablishing corner:


I-12: Cor. common to Sec. 34 & 35, T27N-R7W, Kalkaska
Fd 1 1/4" x 18" iron bar (frost pin), 6' West of c/l of Saunders Rd.
Pulled and replaced with 5/8" x 18" R.B. w/brass cap in Mon.box. No GLO witnesses were found. The Kalkaska Co. peer group approved the above monument and is accepted as the best available evidence of the position of the original corner.

Ratified by Peer Group
P.A. 345-1990 Kalkaska County

Chairman Eugene Farrier
Date 12-19-95

C. Description of monument for corner and accessories established to perpetuate locating the position of the corner:

I-12: Cor. common to Sec. 34 & 35, T27N-R7W, Kalkaska
Fd 1 1/4" x 18" iron bar (frost pin). Pulled and replaced with 5/8" x 18" R.B. w/ brass cap in Mon.box.
Set nail & tag, S85E, P.P., 43.08'
Set nail & tag, N40W, 12" R. Pine, 67.16'
Set nail & tag, S46W, 30" Maple, 94.25'
Set nail & tag, N83W, 14" R. Pine, 78.56'

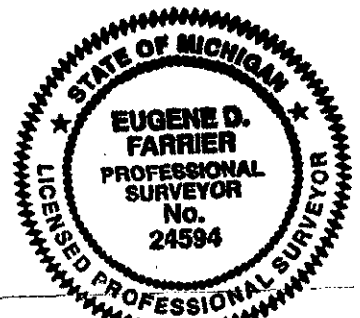

Signed by Eugene Farrier
Surveyor's Michigan License No. 24594

Date 12-22-95

FORM APPROVED BY MICHIGAN STATE BOARD OF LAND SURVEYORS, JAN. 28, 197
REVISED MAY 14, 197
REVISED JAN., 199