

FEB 18 1994

COMMISSION

LAND CORNER RECORDATION CERTIFICATE
Filing Requirement of Act 74, Mich. P.A. 1970

For corners in

Form with fields for KALKASKA (County), Located In: T 27N R 7W, Corner Code # J-9, and numbered items 1-5 describing survey types and lot numbers.

KALKASKA COUNTY, MICHIGAN RECEIVED

1993 DEC 22 PM 1:33

Signature of Joan Hall, REG. OF DEEDS

Register of Deeds Stamp & File Number

I, EUGENE FARRIER, in a field survey on DEC. 1, 19 93, do hereby certify that under requirements of P.A. 74, Michigan P.A. of 1970, the corner points mentioned in lines 1 and 2 above were in conformance with regulations and rules therefore as required in the current manual of survey instructions of the United States Department of the Interior, Bureau of Land Management or by a decree of a Court of Law and/or that the corner points mentioned in lines 3, 4 and 5 above were in conformance with the rules of the Michigan Board of Land Surveyors or by a Decree of a Court of Law; established, re-established, monumented, re-monumented, recovered, found as expressed below:

NOTE: Not more than 4 corners, all in the same town and range, may be recorded on this certificate.

Grid table with columns A-L and rows 2-13, containing numbers 1-36 and a dot in cell J-9.

A. Description of original monument and accessories and/or subsequent restoration:


- List of survey records including: J-9 cor. common to Sec. 23 & 26, T27N-R7W; 1850 GLO re-survey; 6-15-1883, E. Mosher, Co. Surv.; 8-22-07, W.S. Merrill, Co. Surv.; 5-10-75, D. E. Porter; 5-21-75, LCRC; 7-77, A.L. Dragoo; 8-28-87, N.B. DeYoung; 3-5-91, N.L. Way.

B. Description of corner evidence found and/or method applied in restoring or reestablishing corner:

J-9 cor. common to Sec. 23 & 26, T27N-R7W. Found 3/4"x20" iron bar in Mon. Box, 1' East of N-S fnc line to South. On 12-16-93 the Kalkaska Co. peer group approved the above monument as a careful and faithful reestablishment of the position of the original corner.

C. Description of monument for corner and accessories established to perpetuate locating the position of the corner:

J-9 cor. common to Sec. 23 & 26, T27N-R7W. Found 3/4"x20" iron bar in Mon. Box - Pulled rod and replaced w/ 5/8"x18" re-rod w/ Brass Cap. North, 100.10', Iron & cap (#15410), fd. N25E, 73.32', 10" R. Pine, fd nail & tag E. fc. N45W, 90.52', 8" R. Pine, fd nail & tag SW. fc. S20W, 97.77', 8" Elm, fd nail & tag E. fc.

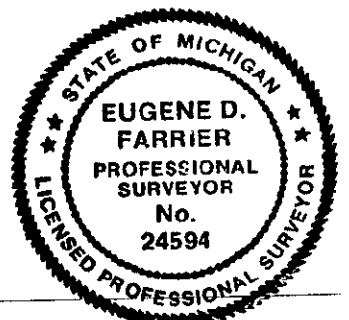

Signed by Eugene FARRIER, Surveyor's Michigan License No. 24594

Date 12-22-93