

FEB 18 1994

COMMISSION

LAND CORNER RECORDATION CERTIFICATE
Filing Requirement of Act 74, Mich. P.A. 1970

KALKASKA COUNTY, MICHIGAN
RECEIVED

1993 DEC 22 PM 1:34

Joan Hall
REG. OF DEEDS

For corners in

<u>KALKASKA</u> (County)	Located In:	Corner Code #
1993 REMONUMENTATION		
1. Public Land Survey	T <u>27N</u> R <u>7W</u>	<u>K-11</u>
	T _____ R _____	_____
	T _____ R _____	_____
	T _____ R _____	_____
2. Property Controlling in Section	S _____ T _____ R _____	_____
	S _____ T _____ R _____	_____
3. Miscellaneous Property in Sec.	S _____ T _____ R _____	_____
	S _____ T _____ R _____	_____

Register of Deeds Stamp & File Number

- 4. Lot No. _____, Recorded Plat _____
- 5. Private Claims _____

I, EUGENE FARRIER, in a field survey on NOV. 24, 19 93, do hereby certify that under requirements of P.A. 74, Michigan P.A. of 1970, the corner points mentioned in lines 1 and 2 above were in conformance with regulations and rules therefore as required in the current manual of survey instructions of the United States Department of the Interior, Bureau of Land Management or by a decree of a Court of Law and/or that the corner points mentioned in lines 3, 4 and 5 above were in conformance with the rules of the Michigan Board of Land Surveyors or by a Decree of a Court of Law; established, re-established, monumented, re-monumented, recovered, found as expressed below:

NOTE: Not more than 4 corners, all in the same town and range, may be recorded on this certificate.

A	B	C	D	E	F	G	H	I	J	K	L	I
2	6		5		4		3		2		1	
3												
4	7		8		9		10		11		12	
5												
6	18		17		16		15		14		13	
7												
8	19		20		21		22		23		24	
9												
10	30		29		28		27		26		25	
11												
12	31		32		33		34		35		36	
13												

A. Description of original monument and accessories and/or subsequent restoration:

K-11 cor. common to Sec. 25, 26, 35 & 36, T27N-R7W
 1850 GLO re-survey; set post, Sugar 24", S45E, 27; Beech 22", N30W, 62.
 1902, W.S. Merrill, iron stake, set wit. stake 2 rods N. & 2 rods E.
 12-16-01, W.S. Merrill, Iron gas pipe.
 8-23-74, LCRC Liber 1 Pg 332.
 11-10-76, J.L. Fletcher Fd 1 1/2" pipe, Liber 1 Pg 956 of Surv.
 7-77, A.L. Drago, iron pipe, Liber 2 Pg 30 of Surv.
 5-2-80, J.L. Fletcher Fd 1 1/2" pipe, Liber 2 Pg 552 of Surv.
 2-15-88, LCRC Liber 2 Pg 339.

B. Description of corner evidence found and/or method applied in restoring or reestablishing corner:


K-11 cor. common to Sec. 25, 26, 35 & 36, T27N-R7W
 Found 1 1/4" iron pipe 3' West of & 2' North of the intersection of C/L of Tyler road & C/L Golden road 1.0' below surface. Found 1/2"x18" re-bar w/ obliterated cap in center of pipe. GLO witnesses fell in road fill area.
 On 12-16-93 the Kalkaska Co. peer group approved the above monument as a careful and faithful reestablishment of the position of the original corner.

C. Description of monument for corner and accessories established to perpetuate locating the position of the corner:

K-11 cor. common to Sec. 25, 26, 35 & 36, T27N-R7W
 Found 1 1/4" iron pipe w/ 1/2"x18" re-bar in center of pipe - left pipe and drove 5/8"x36" re-bar w/ Brass Cap in pipe 0.7' below ground.
 S35E, 80.54', 5" Spruce, set.
 S45W, 70.68', P. Pole, fd.
 N40W, 34.38', Pipeline mile marker.
 N75E, 62.03', Con. Power Co. pipeline marker.

Signed by *Eugene Farrier*
 Surveyor's Michigan License No. 24594

Date 12-22-93

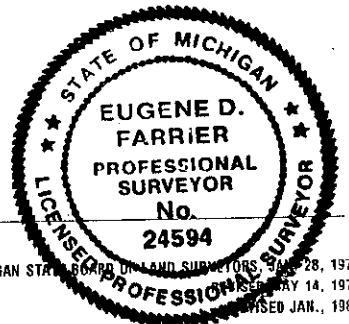

FORM APPROVED BY MICHIGAN STATE BOARD OF LAND SURVEYORS, MAY 14, 1977
 REVISED JAN., 1980