

SURVEY &
REMONUMENTATION

FEB 18 1994

LAND CORNER RECORDATION CERTIFICATE
Filing Requirement of Act 74, Mich. P.A. 1970

For corners in **COMMISSION**

KALKASKA COUNTY, MICHIGAN
RECEIVED

1993 DEC 22 PM 1:35

Jean Hall
REG. OF DEEDS

Register of Deeds Stamp & File Number

<u>KALKASKA</u> (County) 1993 REMONUMENTATION	Located In:	Corner Code ##
1. Public Land Survey	T <u>27N</u> R <u>7W</u>	<u>L-11</u>
	T _____ R _____	_____
	T _____ R _____	_____
	T _____ R _____	_____
2. Property Controlling in Section	S _____ T _____ R _____	_____
	S _____ T _____ R _____	_____
3. Miscellaneous Property in Sec.	S _____ T _____ R _____	_____
	S _____ T _____ R _____	_____
4. Lot No. _____, Recorded Plat _____		
5. Private Claims _____		

	A	B	C	D	E	F	G	H	I	J	K	L	I
2	6		5		4		3		2		1		
3													
4	7		8		9		10		11		12		
5													
6	16		17		18		19		20		21		22
7													
8	19		20		21		22		23		24		
9													
10	30		29		28		27		26		25		
11													
12	31		32		33		34		35		36		
13													

I, EUGENE FARRIER, in a field survey on NOV. 24, 19 93, do hereby certify that under requirements of P.A. 74, Michigan P.A. of 1970, the corner points mentioned in lines 1 and 2 above were in conformance with regulations and rules therefore as required in the current manual of survey instructions of the United States Department of the Interior, Bureau of Land Management or by a decree of a Court of Law and/or that the corner points mentioned in lines 3, 4 and 5 above were in conformance with the rules of the Michigan Board of Land Surveyors or by a Decree of a Court of Law; established, re-established, monumented, re-monumented, recovered, found as expressed below:

NOTE: Not more than 4 corners, all in the same town and range, may be recorded on this certificate.

A. Description of original monument and accessories and/or subsequent restoration:

L-11 cor. common to Sec. 25 & 36, T27N-R7W
10-30-73, J.L. Fletcher, Liber 1 Pg 634 of Surv.
11-10-76, J.L. Fletcher, fd 1/2" rod, Liber 1 Pg 956 of Surv.
6-18-83, E. Farrier, fd 1/2" rod, Liber 2 Pg 776 of Surv.

B. Description of corner evidence found and/or method applied in restoring or reestablishing corner:


L-11 cor. common to Sec. 25 & 36, T27N-R7W
Found and accepted 1/2"x24" re-bar 0.3' below rd grad. 2' N. of C/L Tyler Rd. and 14" W. of C/L Riely Rd.
On 12-16-93 the Kalkaska Co. peer group approved the above monument as a careful and faithful reestablishment of the position of the original corner.

C. Description of monument for corner and accessories established to perpetuate locating the position of the corner:

L-11 cor. common to Sec. 25 & 36, T27N-R7W
Fd. 1/2"x24" re-bar, pulled & set 5/8"x36" re-bar w/ brass cap, 0.7' below ground.
S63E, 165.66', P. Pole, fd.
S28W, 34.42', "X" in W. end 18" Conc. Pipe.
S50E, 107.22', P. Pole, set.
N33E, 171.44', SW Cor. House.

Signed by *Eugene Farrier*
Surveyor's Michigan License No. 24594

Date 12-22-93

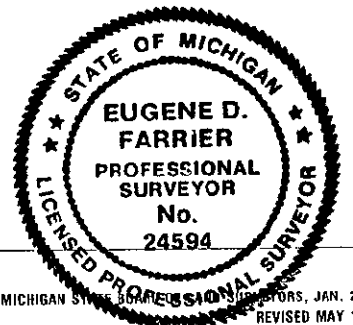

FORM APPROVED BY MICHIGAN STATE BOARD OF PROFESSIONAL SURVEYORS, JAN. 28, 1971
REVISED MAY 14, 1971
REVISED JAN., 1991