

SURVEY & REMONUMENTATION

FEB 18 1994

LAND CORNER RECORDATION CERTIFICATE
Filing Requirement of Act 74, Mich. P.A. 1970

For corners in COMMISSION

KALKASKA COUNTY, MICHIGAN RECEIVED

1993 DEC 22 PM 1:36

Joan Hall
REG. OF DEEDS

Register of Deeds Stamp & File Number

Form with fields for KALKASKA (County), 1993 REMONUMENTATION, and survey details including Public Land Survey, Property Controlling in Section, Miscellaneous Property in Sec., Lot No., and Recorded Plat.

Grid table with columns A-L and rows 2-13, containing numbers 1-36.

I, EUGENE FARRIER, in a field survey on NOV. 24, 1993, do hereby certify that under requirements of P.A. 74, Michigan P.A. of 1970, the corner points mentioned in lines 1 and 2 above were in conformance with regulations and rules therefore as required in the current manual of survey instructions of the United States Department of the Interior, Bureau of Land Management or by a decree of a Court of Law and/or that the corner points mentioned in lines 3, 4 and 5 above were in conformance with the rules of the Michigan Board of Land Surveyors or by a Decree of a Court of Law; established, re-established, monumented, re-monumented, recovered, found as expressed below:

NOTE: Not more than 4 corners, all in the same town and range, may be recorded on this certificate.

A. Description of original monument and accessories and/or subsequent restoration:


M-11 cor. common to Sec. 25 & 36, T27N-R7W & Sec. 30 & 31, T27N-R6W 1850 GLO re-survey; Beech 10" for cor. 1902, W.S. Merrill, Co. Surv., surv. of S/2 Sec. 30, set iron stk. 9-26-73, LCRC-Liber 1 Pg 249. 10-03-78, J.L. Fletcher, fd. 2" iron pipe, Liber 2 Pg 550 of Surv. 5-20-82, LCRC Liber 2 Pg 311. 6-18-83, E. Farrier, fd. 1 1/4" pipe, Liber 2 Pg 776 of Surv.

B. Description of corner evidence found and/or method applied in restoring or reestablishing corner:

M-11 cor. common to Sec. 25 & 36, T27N-R7W & Sec. 30 & 31, T27N-R6W Found 1 1/4" iron pipe 1.0' below rd. surface & 1.5' North of C/L of Tyler Rd. & in line w/ fnc. N. & S. No GLO witnesses available. On 12-16-93 the Kalkaska Co. peer group approved the above monument as a careful and faithful reestablishment of the position of the original corner.

C. Description of monument for corner and accessories established to perpetuate locating the position of the corner:

M-11 cor. common to Sec. 25 & 36, T27N-R7W & Sec. 30 & 31, T27N-R6W Found 1 1/4" iron pipe. Set 5/8"x36" re-bar w/ brass cap in center of pipe 0.7' below ground. N47E, 41.84', 20" Maple, fd. spk. S30W, 45.60', 18" Maple, fd. spk. S15E, 43.21', 18" W. Pine, fd. spk. N70W, 132.35', P. Pole, set spk. North, 34.4', DNR witness plaque.

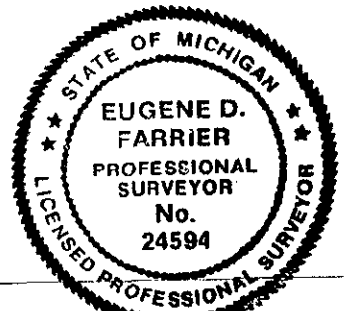

Signed by Eugene Farrier
Surveyor's Michigan License No. 24594

Date 12-22-93

FORM

MICHIGAN STATE BOARD OF LAND SURVEYORS, JAN. 28, 1971
REVISED MAY 14, 1971
REVISED JAN., 1971