

**SURVEY & REMONUMENTATION**

MAR 21 1997

**COMMISSION**

KALKASKA COUNTY, MICHIGAN  
RECEIVED

**LAND CORNER RECORDATION CERTIFICATE**  
Filing Requirement of Act 74, Mich. P.A. 1970

97 JAN 31 PM 2: 26

*Joan Hall*  
REGISTERED

or corners in

KALKASKA  
(County)  
1996 REMONUMENTATION  
Public Land Survey

Located In:	Corner Code -#
T 27N R 6W	A-12
T 27N R 7W	<del>A-12</del> ✓
T _____ R _____	
T _____ R _____	
S _____ T _____ R _____	
S _____ T _____ R _____	
S _____ T _____ R _____	
S _____ T _____ R _____	

- 1. Property Controlling in Section
- 2. Miscellaneous Property in Sec.

Register of Deeds Stamp & File Number

Lot No. \_\_\_\_\_, Recorded Plat \_\_\_\_\_  
Private Claims \_\_\_\_\_

	A	B	C	D	E	F	G	H	I	J	K	L	M
2	6	5	4	3	2	1							
3													
4	7	8	9	10	11	12							
5													
6	18	17	16	15	14	13							
7													
8	19	20	21	22	23	24							
9													
10	30	29	28	27	26	25							
11													
12	31	32	33	34	35	36							
13													

EUGENE FARRIER, in a field survey on Nov. 12, 1996, hereby certify that under requirements of P.A. 74, Michigan P.A. of 1970, the corner points mentioned in lines 1 and 2 above were in conformance with regulations and rules theretofore as required in the current manual of survey instructions of the United States Department of the Interior, Bureau of Land Management or by a decree of a Court of Law and/or that the corner points mentioned in lines 3, 4 and 5 above were in conformance with the rules of the Michigan Board of Land Surveyors or by a Decree of a Court of Law, established, re-established, monumented, re-monumented, recovered, found as expressed below:


**NOTE: Not more than 4 corners, all in the same town and range, may be recorded on this certificate.**

- Description of original monument and accessories and/or subsequent restoration:  
A-12 cor common to Sec. 31, T27N-R6W, Excelsior Township & Sec. 36, T27N-R7W Kalkaska Township  
1850, G.L.O. resurvey, Set Post. 10"Cedar S59W 16, 8"Cedar N80W 12.  
1888, E.Mosher, Co. Surveyor, used corner, no accessories.  
11-10-1972, C.L.Roser, fd old stake set DNR mon, no accessories  
11-10-1972, LCRC Liber 1 pg. 182.  
09-24-1973, J.R.Radcliffe, fd DNR mon. Liber 1 pg. 443 of Survey.  
09-24-1973, LCRC Liber 1 pg. 282.  
09-17-1981, N.F.Parker, fd DNR mon. Liber 2 pg. 824 of Survey.  
06-18-1983, E.D.Farrier, Survey #2583, fd DNR mon, w/ accessories.

- Description of corner evidence found and/or method applied in restoring or reestablishing corner:  
A-12 cor common to Sec. 31, T27N-R6W, Excelsior Township & Sec. 36, T27N-R7W Kalkaska Township  
Found DNR Mon w/ DNR Post, left in place. No G.L.O. witnesses found. The Kalkaska Co. peer group approved & accepted the above monument as a careful and faithful perpetuation of the position of the original corner.

**Ratified by Peer Group**  
**P.A. 345 - 1990 Kalkaska County**  
Chairman Eugene Farrier  
Date 1-21-97

- Description of monument for corner and accessories established to perpetuate locating the position of the corner:  
A-12 cor common to Sec. 31, T27N-R6W, Excelsior Township & Sec. 36, T27N-R7W Kalkaska Township. Found DNR Mon w/ DNR Post, left in place.  
Found nail N85W 7" Hemlock, 13.22'  
Found nail S02E 14" Hemlock, 40.32'  
Found nail S75E 12" Cedar, 36.60'  
Set nail East 4"x4" Cedar Post, 1.25'

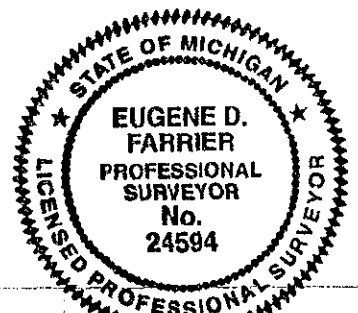

Signed by Eugene Farrier  
Surveyor's Michigan License No. 24594

Date 1-30-97