LAND CORNER RECORDATION CERTIFICATE

Filing Requirement of Act 74, Mich. P.A. 1970

For corners in KALKASKA (County)

	Located In:	Corner Code //
1. Public Land Survey	T 27N R 7W	A-7,A-8
	T ___ R ___	B-7,B-8
	T ___ R ___	
	T ___ R ___	
2. Property Controlling	S ___ T ___ R ___	
in Section	S ___ T ___ R ___	
3. Miscellaneous	S ___ T ___ R ___	
Property in Sec.	S ___ T ___ R ___	

Register of Deeds Stamp & File Number

4. Lot No. _____ , Recorded Plat _____
5. Private Claims _____

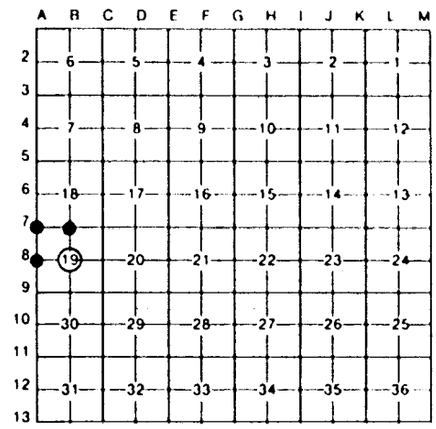

I, C.F.ROSER, in a field survey on SEPTEMBER, 15, 19 91, do hereby certify that under requirements of P.A. 74, Michigan P.A. of 1970, the corner points mentioned in lines 1 and 2 above were in conformance with regulations and rules therefore as required in the current manual of survey instructions of the United States Department of the Interior, Bureau of Land Management or by a decree of a Court of Law and/or that the corner points mentioned in lines 3, 4 and 5 above were in conformance with the rules of the Michigan Board of Land Surveyors or by a Decree of a Court of Law; established, re-established, monumented, re-monumented, recovered, found as expressed below:

NOTE: Not more than 4 corners, all in the same town and range, may be recorded on this certificate.

A. Description of original monument and accessories and/or subsequent restoration:

A-7 A-8 B-7 B-8

STATE OF MICHIGAN
CARL F. ROSER
LAND SURVEYOR
No. 12028
REGISTERED LAND SURVEYOR

B. Description of corner evidence found and/or method applied in restoring or reestablishing corner:

A-7
FD AND ACCEPTED IRON FOR NW COR SEC 19. IRON FITS RLS, J.WILCOX DATA PER HIS 1973 SURVEY OF SEC 19. CTR OF DIRT RD SOUTH IS 13' EAST.

A-8
FD 1/2" PIPE FOR W1/4 COR S-19. PIPE FITS LS, J.WILCOX CERT. OF SURVEY DATA, RECORDED IN LI. 1, PG. 424, DATED 1973. FD M.SCHAAF MON, N20°31'E, 10.43' (NOT ACCEPTED). FD PIPE FALLS AT W. EDGE OF N-S SAND-GRAVEL ROAD.

B-7
FD AND ACCEPTED IRON FOR N1/4 COR OF SEC 19 AS NOTED IN J.WILCOX CERT OF SURVEY, LI. 1, PG. 424, DATED 8-30-73. CTR OF E-W B.TOP RD IS 2.8' NORTH.

B-8
REMONUMENTD CTR OF SEC 19 PER WILCOX, ERICKSON & ASSOC INC CERTIFICATE OF SURVEY RECORDED AT REGISTER OF DEEDS, LIBER 1, PAGE 424 IN 1973. NORTH EDGE OF 9'± WIDE CREEK IS 34' SOUTH. CTR OF E-W TRAIL IS 47' NORTH.

C. Description of monument for corner and accessories established to perpetuate locating the position of the corner:

A-7
FD IRON WITH BATTERED LS CAP IN CTR OF E-W B.TOP RD.

7"J.PINE	N40°E	47.41'
12"J.PINE	N34°W	47.09'
7"J.PINE	S05°W	41.85'
6"J.PINE	S58°E	71.40'

SET CED POST W/LOC TAG BESIDE FD CON. MON. NORTH 33'

A-8
FD 1/2" PIPE.

9" J.PINE	N46°E	60.82'
6" ASPEN	N32°E	68.79'
6" MAPLE(CLP)	N70°E	70.58'
8" J.PINE	N18°W	45.56'

SET CED POST W/LOC TAG. WEST 16.5'

B-7
FD IR WITH BATTERED LS CAP.

‡7" J.PINE	N35°E	50.25'
‡7" J.PINE	S14°W	39.96'
‡FD CON MON	NORTH	33.00'

FD IRON WITH LS. CAP #33969 SOUTH 32.98'

‡= J.WILCOX WIT.

B-8
DROVE 1"X 54" PIPE W/LS CAP & SET CED POST W/LOC TAG.

‡20" W.PINE	N60°W	24.49'
20"TW.R.OAK	N25°E	23.42'
18" R.PINE	S55°E	28.45'
‡24" R.OAK	S25°W	12.10'

FD 1/2" REROD W/LS CAP #14102 N00°23'E 150.00'

‡= WILCOX & ASSOC. WIT.

Signed by Carl F. Roser 1-15-94 Date

Surveyor's Michigan License No. 12028

FORM APPROVED BY MICHIGAN STATE BOARD OF LAND SURVEYORS, JAN 28, 1971
REVISED MAY 14, 1975
REVISED JAN 1983