

MICHIGAN
DEPARTMENT OF CONSERVATION
FORESTRY DIVISION



LAND CORNER RECORD

T. 27 N.R. 8 W


Kalkaska COUNTY

DESCRIPTION OF CORNER 1/4 corner common to Sections 5 - 8

CORNER MONUMENT Set 1" pipe with 4" Aluminum cap

DATE MONUMENT PLACED AND WITNESSED 4-26-67

WITNESSES TO CORNER.....

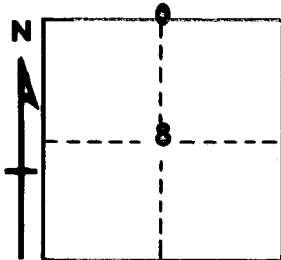

10" H. Maple N 10 W 30.3°

10" Elm S 63 E 32.0°

AND _____


CIRCLE CORNER REGISTERED

DESCRIPTION IN DETAIL AS TO HOW CORNER WAS LOCATED AND IDENTIFIED OR RESTORED.

This corner was set by proportionate measurement, midpoint on line, between section corners, during a survey in this township.

Nothing left for previous corner in cut section of road.

Fence lines inconclusive as support to any previous corner.

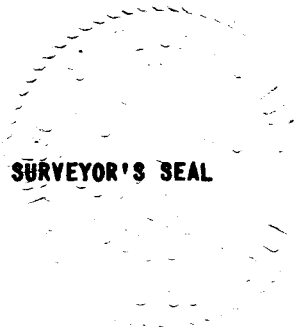

SIGNED _____ DATE 4-26-67
REGISTERED LAND SURVEYOR #10068