

**LAND CORNER RECORDATION CERTIFICATE**  
**Filing Requirement of Act 74, Mich. P.A. 1970**

For corners in

**SURVEY &  
 REMONUMENTATION**

**FEB 26 2001**

**SECTION**

KALKASKA Located In: \_\_\_\_\_ Corner Code # \_\_\_\_\_  
 (County)

**2000 REMONUMENTATION**


1. Public Land Survey T 27N R 7W E-3  
 T \_\_\_\_\_ R \_\_\_\_\_  
 T \_\_\_\_\_ R \_\_\_\_\_  
 T \_\_\_\_\_ R \_\_\_\_\_

2. Property Controlling in Section S \_\_\_\_\_ T \_\_\_\_\_ R \_\_\_\_\_  
 S \_\_\_\_\_ T \_\_\_\_\_ R \_\_\_\_\_

3. Miscellaneous Property in Sec. S \_\_\_\_\_ T \_\_\_\_\_ R \_\_\_\_\_  
 S \_\_\_\_\_ T \_\_\_\_\_ R \_\_\_\_\_

4. Lot No. \_\_\_\_\_, Recorded Plat \_\_\_\_\_

5. Private Claims \_\_\_\_\_

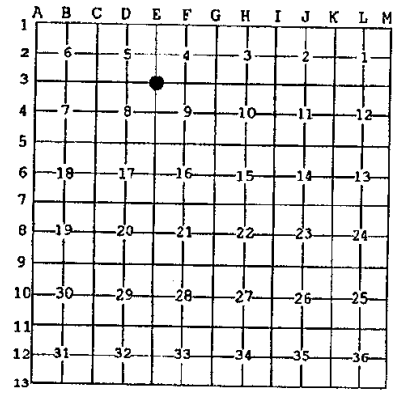

I, EUGENE FARRIER, in a field survey on AUGUST 31, 2000 do hereby state that under requirements of P.A. 74, Michigan P.A. of 1970, the corner points mentioned in lines 1 and 2 above were in conformance with regulations and rules therefore as required in the current manual of survey instructions of the United States Department of the Interior, Bureau of Land Management or by a decree of a Court of Law and /or that the corner points mentioned in lines 3, 4 and 5 above were in conformance with the rules of the Michigan Board of Land Surveyors or by a Decree of a Court of Law; established, re-established, monumented, recovered, found as expressed below:

**NOTE:** Not more than 2 corners, all in the same town and range, may be recorded on this certificate.

A. Description of original monument and accessories and/or subsequent restoration:  
**E-3: Sec. Cor. Common to Secs. 4, 5, 8 & 9, T27N-R7W, Kalkaska Twp**  
 1850, G.L.O. Resurvey, by Lucius Lyon, set Hemlock post for Section corner; Beech 16", N50°W, 8 Lks; Beech 12", S32°E, 28 Lks  
 1903, Survey, by W.S. Merrill (Co. Surveyor), Bk 25, Pg 8, shows corner but not description or accessories  
 1971, Survey, by C.E. Ostling, not recorded, found 1/2" rod at corner, no accessories  
 1972, Surveys, by L. Gerschbacher, Liber 1, Pg 184-185; Liber 1, Pg 860, found 1/2" rerod at corner; power pole, N18°E, 126.75'; power pole, S30°E, 66.21'; Red Pine 6", S40°W, 70.80'  
 1979-1991, LCRC, by F.H. Thomson, Liber 2, Pg 198 & Survey in Liber 2, Pg 507; & Survey, by E. Farrier (Co. Surveyor) (4-not recorded), all found 5/8" rerod or 1/2" rerod at corner in centerline road to East and 1' West of centerline North-South road; Red Pine 8", S65°W, 72.50'; Poplar 5", N60°W, 43.45'; Red Pine 8", N80°E, 77.41'; power pole, S25°E, 65.95'

B. Description of corner evidence found and/or method applied in restoring or reestablishing corner:  
**E-3: Sec. Cor. Common to Secs. 4, 5, 8 & 9, T27N-R7W, Kalkaska Twp**  
 Found 3/4" iron pipe with 1/2" iron rod in center, in centerline Beebe Road North-South & 5' North of Metzger Road to West.  
 No G.L.O. witnesses were found.

C. Description of monument for corner and accessories established to perpetuate locating the position of the corner:  
**E-3: Sec. Cor. Common to Secs. 4, 5, 8 & 9, T27N-R7W, Kalkaska Twp**  
 Pulled & set 5/8" X 18" rerod with brass Co. mon.  
 N12°E, 17.54', 1 1/4" iron pipe  
 N41°W, 83.20', Maple 6" in clump, set nail & tag  
 S22°E, 68.66', power pole, set nail & tag  
 S68°W, 72.48', Red Pine 12", set nail & tag  
 Kalkaska County Peer Group accepted the above monument as the best available evidence of the position of the original corner.



Signed by Eugene Farrier Date 2-15-01  
 Surveyor's Michigan License No. 24594

FORM APPROVED BY MICHIGAN STATE BOARD OF PROFESSIONAL SURVEYORS, JAN. 29, 1971  
 REVISED MAY 14, 1976  
 REVISED JAN., 1982  
 REVISED OCT., 1995

Ratified by Peer Group  
 P.A. 345-1990 Kalkaska County

Chairman Eugene Farrier  
 Date 2-15-01

  
**3026869**  
 Page: 1 of 1  
 02/16/2001 10:25A  
 REJON  
 LB: 6 PG: 198  
 Kalkaska County Joan Hall, Register