

MICHIGAN  
DEPARTMENT OF CONSERVATION  
FORESTRY DIVISION



# LAND CORNER RECORD

T. 27 N.R. 8 W


Kalkaska COUNTY

DESCRIPTION OF CORNER 1/4 Corner common to Sections 4 - 5

CORNER MONUMENT Set 1" pipe with 4" aluminum cap

DATE MONUMENT PLACED AND WITNESSED 4-26-67

WITNESSES TO CORNER.....

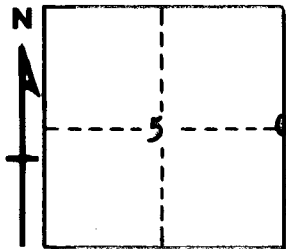

CIRCLE CORNER REGISTERED


10" H. Maple	N 16 E	22.5'
8" Tw. H. Maple	S 83 W	49.3'

AND

DESCRIPTION IN DETAIL AS TO HOW CORNER WAS LOCATED AND IDENTIFIED OR RESTORED.

This corner was restored by proportionate measurement, midpoint on line, between section corners, during a survey in this township.

Nothing left for U.S. evidence or a previous corner. Falls approximately in old township road grade N-S.

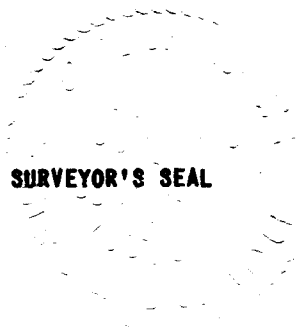

SURVEYOR'S SEAL

SIGNED \_\_\_\_\_ DATE 4-26-67  
REGISTERED LAND SURVEYOR #10068