

MICHIGAN  
DEPARTMENT OF CONSERVATION  
FORESTRY DIVISION



# LAND CORNER RECORD

T. 27 N.R. 8 W


Kalkaska COUNTY

DESCRIPTION OF CORNER 1/4 corner common to Sections 11 - 14

CORNER MONUMENT Set 1" pipe with 4" Alum. Cap

DATE MONUMENT PLACED AND WITNESSED 4-26-67

WITNESSES TO CORNER.....

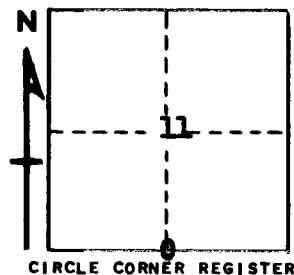

24" W. Pine Stp. S 60 E 3.1'


8" J. Pine N 24 W 12.3'

AND \_\_\_\_\_

DESCRIPTION IN DETAIL AS TO HOW CORNER WAS LOCATED AND IDENTIFIED OR RESTORED.

This corner was set by proportionate measurement, midpoint on line, between section corners.

Unable to positively identify U.S. evidence, and no previous corner found.

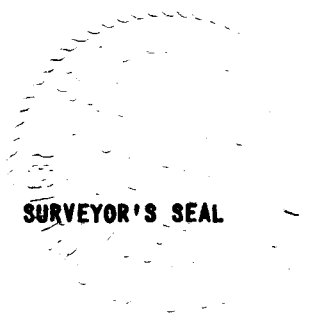

SURVEYOR'S SEAL

SIGNED \_\_\_\_\_ DATE 4-26-67  
REGISTERED LAND SURVEYOR #10068