LAND CORNER RECORDATION CERTIFICATE

Filing Requirement of Act 74, Mich. P.A. 1970

For corners in KALKASKA (County)

	Located In:	Corner Code ##
1. Public Land Survey	T 27N R 8W	I-9, I-10,
	T ___ R ___	J-10
	T ___ R ___	
	T ___ R ___	
2. Property Controlling	S 26 T ___ R ___	8
in Section	S ___ T ___ R ___	
3. Miscellaneous	S ___ T ___ R ___	
Property in Sec.	S ___ T ___ R ___	

Register of Deeds Stamp & File Number

4. Lot No. _____ , Recorded Plat _____
5. Private Claims _____

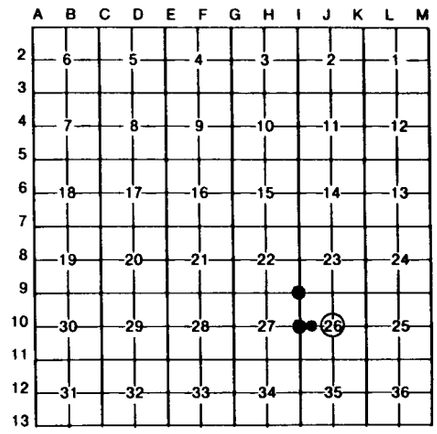

I, CARL KIISKILA, in a field survey on SEPT. 11, 19 95, do hereby certify that under requirements of P.A. 74, Michigan P.A. of 1970, the corner points mentioned in lines 1 and 2 above were in conformance with regulations and rules therefore as required in the current manual of survey instructions of the United States Department of the Interior, Bureau of Land Management or by a decree of a Court of Law and/or that the corner points mentioned in lines 3, 4 and 5 above were in conformance with the rules of the Michigan Board of Land Surveyors or by a Decree of a Court of Law; established, re-established, monumented, re-monumented, recovered, found as expressed below:

NOTE: Not more than 4 corners, all in the same town and range, may be recorded on this certificate.

A. Description of original monument and accessories and/or subsequent restoration:

I-9 I-10 J-10 8

(NO EVIDENCE OF G.L.O. CORNER, B.T'S, LINE TREES & TOPOGRAPHY, AS CALLED OUT IN THE G.L.O. LINE NOTES; UNLESS NOTED IN ITEM "B" BELOW.)

STATE OF MICHIGAN
CARL KIISKILA
LAND SURVEYOR
No. 33981
LICENSED LAND SURVEYOR

B. Description of corner evidence found and/or method applied in restoring or reestablishing corner:

I-9	I-10	J-10	8
NW S-26, FOUND AND ACCEPTED A DEPARTMENT OF CONSERVATION MON. (WITH CAP BROKEN OFF) AS SET IN 1951 AT POSITION PREVIOUSLY LOCATED AND PERPETUATED BY MARCUS SCHAAF. ONE ORIGINAL BT STILL IN PLACE IN 1951. SET NEW DNR MON. IN ITS PLACE. CTR OF E-W TRAIL IS 10' NORTH. CORNER FALLS IN CTR OF OLD OVER GROWN TRAIL ROAD TO SOUTH.	FD. AND ACCEPTED 1/2" IRON ROD W/PS CAP AS SET BY J.WILCOX P.S, IN 1978, MIDWAY AND ON LINE BETWEEN SECTION CORNERS 1/2 MILE TO N & S, FOR W1/4 COR. SEC. 26.	ESTABLISHED THE CENTER OF SEC. 26 AT INTERSECTION OF 1/4 LINES.	ESTABLISHED THE NE CORNER OF THE NW1/4 OF THE SW1/4 OF SECTION 26 BY STANDARD BLM PROCEDURE FOR SUBDIVISION OF A SECTION.

C. Description of monument for corner and accessories established to perpetuate locating the position of the corner:

I-9

FD. 1" PIPE W/BROKEN RIVETED CONS. DEPT. CAP, REPLACED W/STD. DEPT. MON. AND SET CARSONITE POST.

#4"R.PINE	N79°W	18.30'
#14"R.PINE	N62°E	96.52'
3" R.PINE	N16°W	27.41'
13"R.PINE	S10°W	46.94'

#= J.WILCOX WIT. Li.2, Pg.195

I-10

SET STD. DNR MON. OVER FD 1/2" CAPPED IRON, PS #14102.

#5" J.PINE	S05°E	23.56'
#6" B.CHERRY	S47°W	30.63'
5" J.PINE	N42°W	38.97'
7" R.PINE	N62°E	52.25'

#= J.WILCOX, WIT. Li.2, Pg.195

J-10

SET 5/8"x 32" REROD W/PS CAP & CARSONITE POST.

8" J.PINE	S52°E	4.15'
6" R.MAPLE	S58°W	29.23'
10" R.MAPLE	N47°W	24.04'
9" J.PINE	N23°E	22.92'

8

SET 5/8"x 32" REROD W/PS CAP & CARSONITE POST.

5"R.MAPLE	N48°E	23.26'
10"J.PINE	N33°W	33.77'
8"J.PINE	S42°W	36.63'
6" OAK	S49°E	57.82'

Signed by Carl T. Kiiskila Date 12-7-95

Surveyor's Michigan License No. 33981

FORM APPROVED BY MICHIGAN STATE BOARD OF LAND SURVEYORS, JAN. 28, 1971
REVISED MAY 14, 1975
REVISED JAN., 1983