

# LAND CORNER RECORDATION CERTIFICATE

Filing Requirement of Act 74, Mich. PA 1970


For Corners In: <u>Kalkaska</u> (County)	Located In	Corner Code #	
1. Public Land Survey	T <u>27N</u> R <u>8W</u>	<u>A-2</u>	
	T _____ R _____	_____	
2. Property Controlling in Section	S _____ T _____ R _____	_____	
	S _____ T _____ R _____	_____	
3. Miscellaneous Property in Section	S _____ T _____ R _____	_____	
	S _____ T _____ R _____	_____	

4. Lot No: \_\_\_\_\_ Recorded Plat: \_\_\_\_\_

5. Private Claims: \_\_\_\_\_

I, Craig W. McVean, in a field survey on Oct. 28, 1999 do hereby state that under requirements of PA 74, Michigan PA of 1970, the corner points mentioned in lines 1 and 2 above were in conformance with regulations and rules therefore as required in the current manual of survey instructions of the United States Department of the Interior, Bureau of Land Management or by a decree of a Court of Law and/or that the corner points mentioned in lines 3, 4 and 5 above were in conformance with the rules of the Michigan Board of Land Surveyors or by a Decree of a Court of Law; established, re-established, monumented, recovered, found as expressed below:

**NOTE: Not more than 2 corners, all in the same town and range, may be recorded on this certificate.**

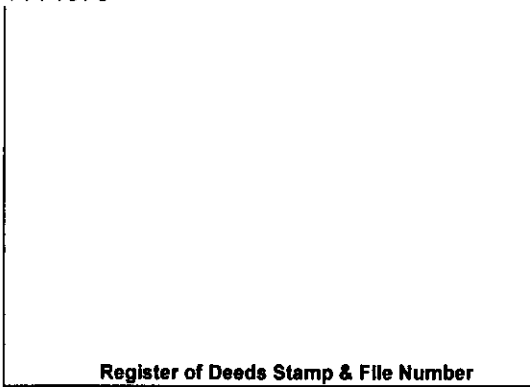

	A	B	C	D	E	F	G	H	I	J	K	L	M
1													
2	6		5		4		3		2		1		
3													
4	7		8		9		10		11		12		
5													
6	18		17		16		15		14		13		
7													
8	19		20		21		22		23		24		
9													
10	30		29		28		27		26		25		
11													
12	31		32		33		34		35		36		
13													

**A. Description of original monument and accessories and/or subsequent restoration:**


- |   |   |
|---|---|
| <p><u>A-2</u> - GLO- set Beech post - L. Lyon -1850<br/>                 Beech 14" N63°W 9 L. Beech 9" S87°E 18 L.<br/>                 - Rd. Sur. Bk. Pg. 51-Kal. Co. Rec.-E. Mosher-1894-Rd Sur. E<br/>                 - L.2, pg.368 - G.T.Co. Rec. - E.P. Waterman -1909<br/>                 large cedar fence post about 8" dia set in place of old Gov't.<br/>                 ¼ post with small stones around &amp; remains of both Gov't. wit.<br/>                 Plain to be seen.<br/>                 - MDNR cor. Rec. -K.J. Ostling -1967<br/>                 found evidence of old fence post set to depth of 3'.<br/>                 Fits E.P Watermans 1909 survey. Set 1" pipe with 4" Alum.<br/>                 Cap. A 4" concrete mon. is 1.7' East of true corner.<br/>                 8" H. Maple S52°W 30.9', 7" Maple clp. N63°E 38.0'</p> | <p>- LCRC - L.2, pg. 485 - G.T.C. rec.- C.F. Roser -1982<br/>                 found DNR monument &amp; added cedar post<br/>                 14" Maple clp. N65°E 37.8'<br/>                 13" Maple S50°W 30.7'<br/>                 6" Oak S25°W 21.5'<br/>                 found Rd. conc. mon. - E. 1.70'</p> |
|---|---|

**B. Description of corner evidence found and/or method applies in restoring or re-establishing corner:**

A-2 - Standard ¼ corner common to Section 1, T27N, R9W & Section 6, T27N, R8W  
 Found 4" DOC (DNR) Alum. Cap on 1" iron pipe per Ostling on C/L Ext. of Sand Rd. to E. per Mosher Rd. survey. Origin of conc. mon. 1.7' East of DOC mon. is unknown. DOC (DNR) monument accepted as a careful and faithful perpetuation of the original corner.

**C. Description of monument for corner and accessories established to perpetuate locating the position of the corner:**

A-2 - Replaced Department of Conservation (DNR) mon. with 3 ¼ " 'Grand Traverse County Remon.' brass cap on 2 ½ " X 30" galvanized iron pipe in a ring of stones.  
 Set blue carsonite post with location tag 1' Northwest  
 East 1.70' to 3/8" iron in concrete monument  
 N62°E 38.25' to set N&T in N side of Tri. 14" R. Maple (KJO, CFR)  
 S26°W 21.77' to set N&T in E side of 8" R. Oak (CFR)  
 S50°W 31.11' to set N&T in NW side of 12" S. Maple (KJO, CFR)  
 N68°W 62.04' to set N&T in NE side of 6" W. Pine scribed 'XBT'

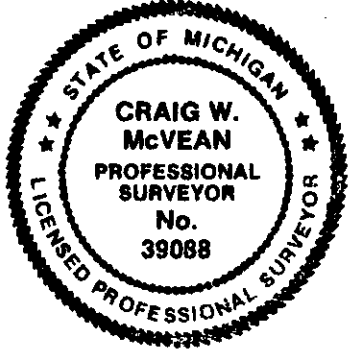

Signed by: Craig W. McVean  
 Surveyor's Michigan License No.: 39088

Date: 1/3/2000