

MICHIGAN
DEPARTMENT OF CONSERVATION
FORESTRY DIVISION

LAND CORNER RECORD

T. 27 N.R. 8 W
T. 28 N.R. 8 W


Kalkaska COUNTY

DESCRIPTION OF CORNER 1/4 corner common to Sections 5-32

CORNER MONUMENT Set 1" pipe with 4" aluminum cap

DATE MONUMENT PLACED AND WITNESSED 4-19-67

WITNESSES TO CORNER.....

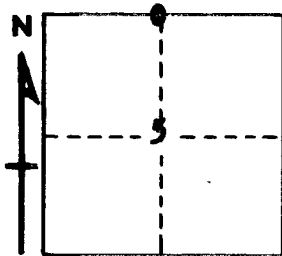

CIRCLE CORNER REGISTERED


6" H. Maple S 36 W 45.5'

14" H. Maple N 36 W 22.1'

AND

DESCRIPTION IN DETAIL AS TO HOW CORNER WAS LOCATED AND IDENTIFIED OR RESTORED.

This corner was set by proportionate measurement, midpoint on line, between section corners during a survey in this area. Falls in old E-W township road grade and in line with old fence line North.

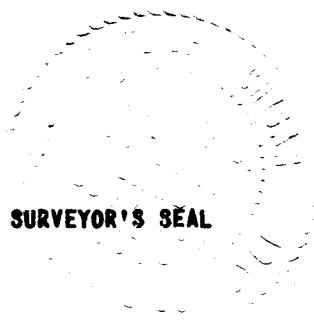

SURVEYOR'S SEAL

SIGNED _____ DATE 4-25-67
REGISTERED LAND SURVEYOR #10068