

MICHIGAN
DEPARTMENT OF CONSERVATION
FORESTRY DIVISION

LAND CORNER RECORD

T. 27 N.R. 8 W


Kalkaska COUNTY

DESCRIPTION OF CORNER 1/4 corner common to Sections 5-6

CORNER MONUMENT Set 1" pipe with 4" aluminum cap

DATE MONUMENT PLACED AND WITNESSED 4-20-67

WITNESSES TO CORNER.....

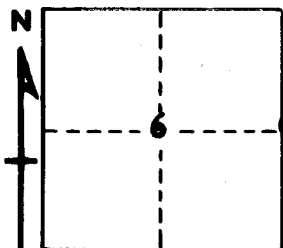


CIRCLE CORNER REGISTERED

	8" H. Maple	N 34 E	18.2'
	6" H. Maple	N 45 W	21.8'

AND

DESCRIPTION IN DETAIL AS TO HOW CORNER WAS LOCATED AND IDENTIFIED OR RESTORED.

This corner was set by proportionate measurement between section corners. Falls between old fence lines running West and East, and acceptably in line with segments of old fence row from South. Checks good to marsh crossing North. Could find no previous corner.

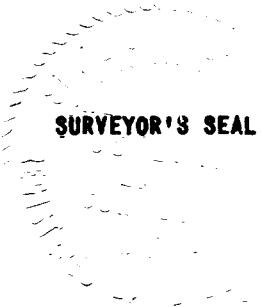

SIGNED _____ DATE 4-25-67

REGISTERED LAND SURVEYOR #10068