

MICHIGAN
DEPARTMENT OF CONSERVATION
FORESTRY DIVISION



LAND CORNER RECORD

T. 27 N.R. 8 W
T. 27 N.R. 9 W


Kalkaska
Grand Traverse COUNTY

DESCRIPTION OF CORNER 1/4 corner common to Sections 18-13

CORNER MONUMENT Set 1" pipe with 4" aluminum cap

DATE MONUMENT PLACED AND WITNESSED 4-13-67

WITNESSES TO CORNER.....

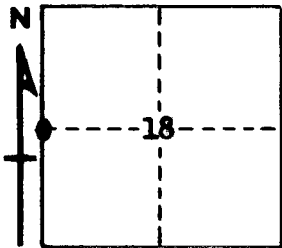

CIRCLE CORNER REGISTERED

7" R. Pine S 64 W 40.4'


10" W. Pine N 52 E 15.8'

AND

DESCRIPTION IN DETAIL AS TO HOW CORNER WAS LOCATED AND IDENTIFIED OR RESTORED.

This corner was found during a survey of T27N, R8W. Found 1" pipe with concrete base at corner, as established in 1934 survey by Marcus Schaaf, R.L.S. In line with firelines N-S-E-W. May have been set from original evidence, although U.S.B.T. would fall in road and stumps have been removed. Unable to find evidence to contrary so accepted this as best available evidence.

SURVEYOR'S SEAL

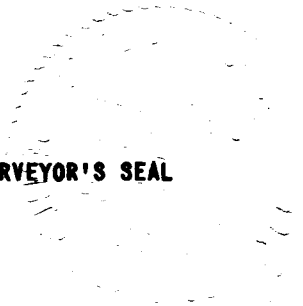

SIGNED _____ DATE 4-25-67

REGISTERED LAND SURVEYOR #10068