

MICHIGAN  
DEPARTMENT OF CONSERVATION  
FORESTRY DIVISION



# LAND CORNER RECORD

T. 27 N.R. 8 W


Kalkaska COUNTY

DESCRIPTION OF CORNER 1/4 corner common to Sections 7-8

CORNER MONUMENT Set 1" pipe with 4" aluminum cap

DATE MONUMENT PLACED AND WITNESSED 4-7-67

WITNESSES TO CORNER.....

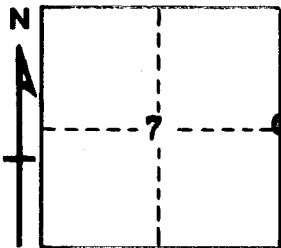

6" H. Maple                      N 85 W                      21.6'


6" H. Maple                      S 5 E                      22.1'

AND

CIRCLE CORNER REGISTERED

DESCRIPTION IN DETAIL AS TO HOW CORNER WAS LOCATED AND IDENTIFIED OR RESTORED.

This corner was found during a survey in this township. Found 1" pipe at corner, in line old fence line west. Checks good for line and distance to section corners north and south.

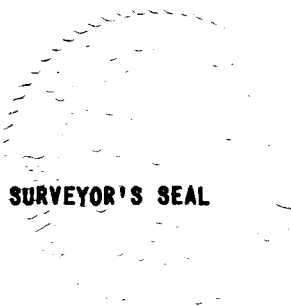

SURVEYOR'S SEAL

SIGNED \_\_\_\_\_ DATE 4-24-67  
REGISTERED LAND SURVEYOR #10068