

MICHIGAN  
DEPARTMENT OF CONSERVATION  
FORESTRY DIVISION

# LAND CORNER RECORD

T. 27 N.R. 8 W


Kalkaska COUNTY

DESCRIPTION OF CORNER 1/4 corner common to Sections 15 - 22

CORNER MONUMENT Set 1" pipe with 4" Alum. cap below surface

DATE MONUMENT PLACED AND WITNESSED 4-26-67

WITNESSES TO CORNER.....

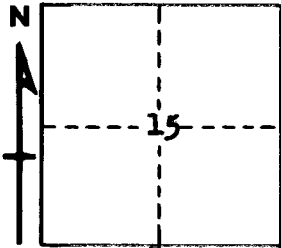

8" J. Pine N 33 E 27.5'


7" J. Pine S 31 E 54.9'

AND \_\_\_\_\_

DESCRIPTION IN DETAIL AS TO HOW CORNER WAS LOCATED AND IDENTIFIED OR RESTORED.

This corner was restored by proportionate measurement, midpoint on line, between section corners, during a survey in this township.

Unable to locate anything for previous corner. Merrill's NBTs gone.

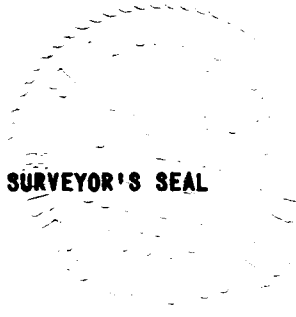

SIGNED \_\_\_\_\_ DATE 4-26-67  
REGISTERED LAND SURVEYOR #10068