

MICHIGAN  
DEPARTMENT OF CONSERVATION  
FORESTRY DIVISION



# LAND CORNER RECORD

T. 27 N.R. 8 W


Kalkaska COUNTY

DESCRIPTION OF CORNER 1/4 corner common to Sections 4 - 9

CORNER MONUMENT Set 1" pipe with 4" aluminum cap

DATE MONUMENT PLACED AND WITNESSED 4-6-67

WITNESSES TO CORNER.....

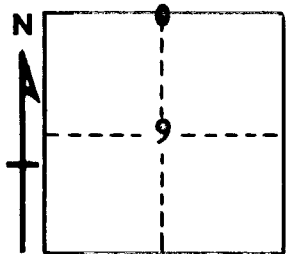

CIRCLE CORNER REGISTERED


5" Maple S 50 W 49.4'

4" W. Pine N 42 E 59.8'

AND \_\_\_\_\_

DESCRIPTION IN DETAIL AS TO HOW CORNER WAS LOCATED AND IDENTIFIED OR RESTORED.

This corner was set by proportionate measurement between section corners. Falls exactly at old fence lines E-W and North.

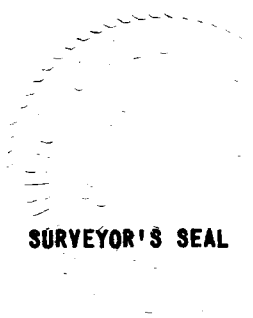

SURVEYOR'S SEAL

SIGNED \_\_\_\_\_ DATE 4-24-67  
REGISTERED LAND SURVEYOR #10068