

MICHIGAN
DEPARTMENT OF CONSERVATION
FORESTRY DIVISION

LAND CORNER RECORD

T. 27 N.R. 8 W


Kalkaska COUNTY

DESCRIPTION OF CORNER Sec. corner common to Sections 8-9-16-17

CORNER MONUMENT Set 1" pipe with 4" aluminum cap

DATE MONUMENT PLACED AND WITNESSED 4-6-67

WITNESSES TO CORNER.....

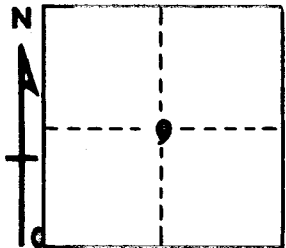

24" H. Maple N 20 W 25.8'


18" W. Pine S 72 W 99.8'

AND

CIRCLE CORNER REGISTERED

DESCRIPTION IN DETAIL AS TO HOW CORNER WAS LOCATED AND IDENTIFIED OR RESTORED.

This corner was found while making a survey in this township. Found a 1" pipe in line with road centerlines south and west. Probably a restoration of early county surveyor's survey of Section 16. Appears acceptable as control for other corners in vicinity.

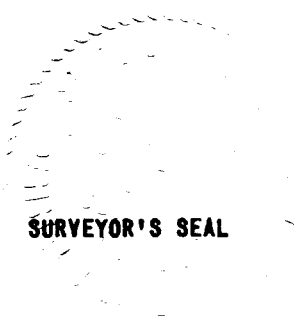

SURVEYOR'S SEAL

SIGNED _____ DATE 4-24-67
REGISTERED LAND SURVEYOR #10068