

MICHIGAN
DEPARTMENT OF CONSERVATION
FORESTRY DIVISION



LAND CORNER RECORD

T. 27 N.R. 8 W


Kalkaska COUNTY

DESCRIPTION OF CORNER 1/4 corner common to Sections 10-15

CORNER MONUMENT Set 1" pipe with 4" aluminum cap

DATE MONUMENT PLACED AND WITNESSED 4-18-67

WITNESSES TO CORNER.....

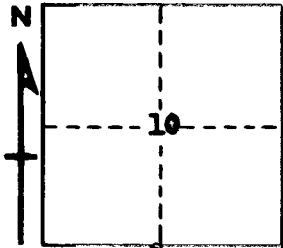

CIRCLE CORNER REGISTERED

16" B. Cherry S 40 E 34.9'


6" R. Pine N 16 W 88.5'

AND

DESCRIPTION IN DETAIL AS TO HOW CORNER WAS LOCATED AND IDENTIFIED OR RESTORED.

This corner was set by proportionate measurement between restored section corners. Nothing left for U.S. evidence or any previous corner. Falls off South edge of E-W trail road.

SURVEYOR'S SEAL

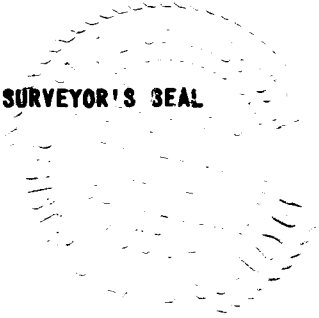

SIGNED _____ DATE 4-25-67
REGISTERED LAND SURVEYOR #10068