

MICHIGAN
DEPARTMENT OF CONSERVATION
FORESTRY DIVISION

LAND CORNER RECORD

T. 27 N.R. 8 W


Kalkaska COUNTY

DESCRIPTION OF CORNER Sec. corner common to Sections 10-11-14-15

CORNER MONUMENT Set 1" pipe with 4" aluminum cap

DATE MONUMENT PLACED AND WITNESSED 4-13-67

WITNESSES TO CORNER.....

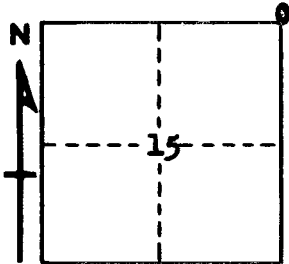


4" R. Pine N 22 W 43.8'

5" R. Pine S 55 E 62.2'

AND _____

DESCRIPTION IN DETAIL AS TO HOW CORNER WAS LOCATED AND IDENTIFIED OR RESTORED.

This corner was set by double proportionate measurement while making a survey in this area. Unable to recover any previous corner and U.S.B.T. all gone. Position falls in line with old firelines South and West, and checks good for distance all directions.

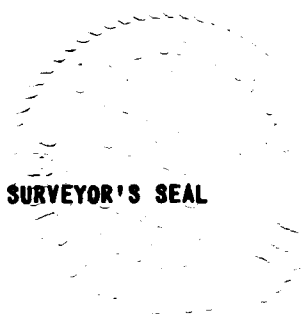

SURVEYOR'S SEAL

SIGNED _____ DATE 4-25-67
REGISTERED LAND SURVEYOR #10068