

MICHIGAN
DEPARTMENT OF CONSERVATION
FORESTRY DIVISION

LAND CORNER RECORD

T. 27 N.R. 8 W


Kalkaska COUNTY

DESCRIPTION OF CORNER 1/4 corner common to Sections 9-10

CORNER MONUMENT Set 1" pipe with 4" aluminum cap

DATE MONUMENT PLACED AND WITNESSED 4-13-67

WITNESSES TO CORNER.....

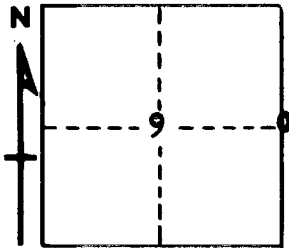

CIRCLE CORNER REGISTERED


12" W. Pine S 47 E 87.5'

6" W. Pine N 40 E 72.8'

AND

DESCRIPTION IN DETAIL AS TO HOW CORNER WAS LOCATED AND IDENTIFIED OR RESTORED.

This corner was established by proportionate measurement, during a survey in this township. Unable to locate any monument of previous surveys, but position is supported by pond edges North and South, with possible locations for U.S.B.T. sites in proper position NW and SE. Two old stakes are located about 1 rod East, but unable to positively determine what they are intended to be. This line checks other physical features very nearly in accord with the U.S. record.

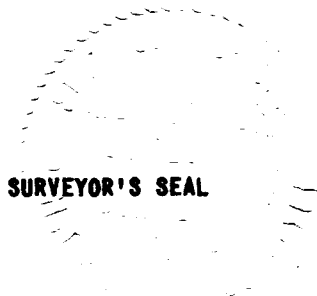

SURVEYOR'S SEAL

SIGNED _____ DATE 4-25-67

REGISTERED LAND SURVEYOR

#10068