


LAND CORNER RECORDATION CERTIFICATE


Filing Requirement of Act 74, Mich. PA 1970

For Corners In: Kalkaska (County)	Located In	Corner Code #	
1. Public Land Survey	T _____ R _____		
	T _____ R _____		
2. Property Controlling in Section	S <u>30</u> T <u>27N</u> R <u>8W</u>		<u>14</u>
	S <u>32</u> T <u>27N</u> R <u>8W</u>		<u>3</u>
3. Miscellaneous Property in Section	S _____ T _____ R _____		
	S _____ T _____ R _____		
4. Lot No: _____	Recorded Plat: _____		
5. Private Claims: _____			

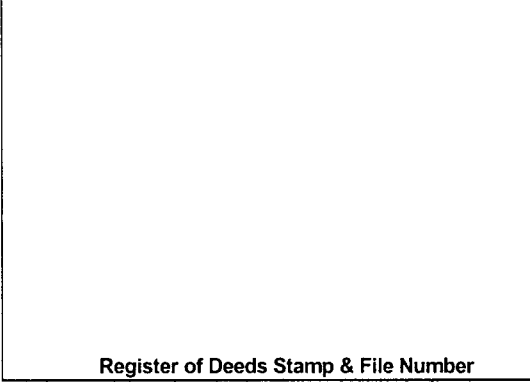

I, Craig W. McVean, in a field survey on _____, 2002 do hereby state that under requirements of PA 74, Michigan PA of 1970, the corner points mentioned in lines 1 and 2 above were in conformance with regulations and rules therefore as required in the current manual of survey instructions of the United States Department of the Interior, Bureau of Land Management or by a decree of a Court of Law and/or that the corner points mentioned in lines 3, 4 and 5 above were in conformance with the rules of the Michigan Board of Land Surveyors or by a Decree of a Court of Law; established, re-established, monumented, recovered, found as expressed below:

NOTE: Not more than 2 corners, all in the same town and range, may be recorded on this certificate.

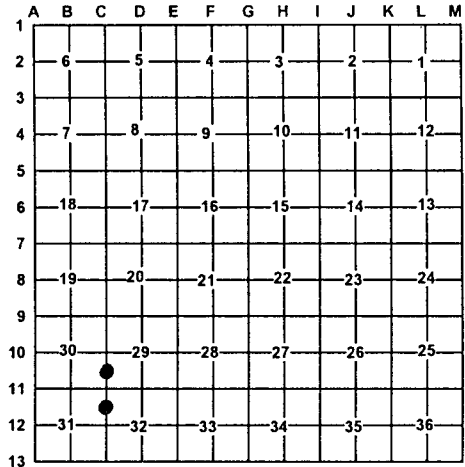

A. Description of original monument and accessories and/or subsequent restoration:

- | | |
|---|---|
| <p><u>14</u> – Rec. Sur. – L. 1, P. 864 – J.L. Fletcher – 1976 – Set iron</p> | <p><u>3</u> – M. Schaaf – 1933 – corrected stake
 - Unrecorded survey – Gourdie – Fraser & Assoc. #83585 – 1983 – iron set – G.F. DeLaMater</p> |
|---|---|

B. Description of corner evidence found and/or method applied in restoring or re-establishing corner:

- | | |
|---|---|
| <p><u>14</u> – S 1/6 corner common to Sec. 29 & 30 – set 2" Alum. Cap on 5/8" x 34" Rebar per standard BLM procedure.</p> | <p><u>3</u> – N 1/16 corner common to Sec. 31 & 32 – set 2" Aluminum Cap on 5/8" x 34" Rebar per standard BLM procedure in N-S fire lane.</p> |
|---|---|

Ref. Pt. – Fd. 1/2" CIR #19830 is S59°28'W 1.57' of Corner '14'. Didn't feel Fletcher position was within required accuracy since his distance from C11 to C9 was 10' shorter than our measurement. 1/2" CIR #19830 not utilized as '14' in this survey.

Ref. Pt. 'A' – Fd. 1 1/4" iron pipe stub in conc. block per Schaaf – N39°45'W 5.69' from Corner '3'. Didn't feel position was within acceptable accuracy. Schaaf monument not utilized as Corner '3' in this survey.

Ref. Pt. 'B' – Fd. CIR #13030 on W. side of W'ly concreted 2 1/2" iron gate post on W. edge of fire lane – S80°10'W 7.99' from Corner '3'. This position doesn't fit calculated position per Gourdie – Fraser's survey and may have been moved. CIR #13030 not utilized as Corner '3' in this survey.

C. Description of monument for corner and accessories established to perpetuate locating the position of the corner:

- | | |
|--|--|
| <p><u>14</u> – 2" AC on 5/8" x 34" Rebar
 NE 1' to set blue carsonite post with location tag
 South 7.40' to set N & T in W. side 17" W. Pine
 S85°W 12.33' to set N & T in N. side 16" R. Oak
 North 22.38' to set N & T in W. side 13" W. Oak
 S66°E 20.52' to set N & T in NW side 8" W. Pine
 S59°28'W 1.57' to Ref. Pt. – 1/2" CIR #19830</p> | <p><u>3</u> – 2" Alum. Cap on 5/8" x 34" Rebar
 SW 1' to set blue carsonite post with location tag.
 S78°E 22.46' to N & T in N side 7" W. Pine
 S46°W 31.98' to N & T in NE side 7" W. Pine
 S58°E 2.88' to face E'ly 2 1/2" steel gate post
 N39°45'W 5.69' to Ref. Pt. 'A' – Schaaf Mon.
 S80°10'W 7.99' to Ref. Pt. 'B' – CIR #13030</p> |
|--|--|

Signed by: Craig W. McVean
 Surveyor's Michigan License No.: 39088

Date: 10/2/2002

