


# LAND CORNER RECORDATION CERTIFICATE


Filing Requirement of Act 74, Mich. PA 1970

For Corners In: <u>Kalkaska</u> (County)	Located In	Corner Code #
1. Public Land Survey	T <u>27N</u> R <u>8W</u>	<u>B13</u>
	T <u>26N</u> R <u>8W</u>	<u>B1</u>
2. Property Controlling in Section	S _____ T _____ R _____	_____
	S _____ T _____ R _____	_____
3. Miscellaneous Property in Section	S _____ T _____ R _____	_____
	S _____ T _____ R _____	_____
4. Lot No: _____	Recorded Plat: _____	
5. Private Claims: _____		

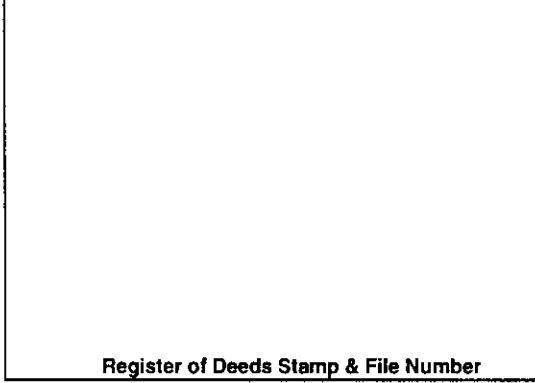

I, Craig W. McVean, in a field survey on July 10, 2002 do hereby state that under requirements of PA 74, Michigan PA of 1970, the corner points mentioned in lines 1 and 2 above were in conformance with regulations and rules therefore as required in the current manual of survey instructions of the United States Department of the Interior, Bureau of Land Management or by a decree of a Court of Law and/or that the corner points mentioned in lines 3, 4 and 5 above were in conformance with the rules of the Michigan Board of Land Surveyors or by a Decree of a Court of Law; established, re-established, monumented, recovered, found as expressed below:

**NOTE: Not more than 2 corners, all in the same town and range, may be recorded on this certificate.**

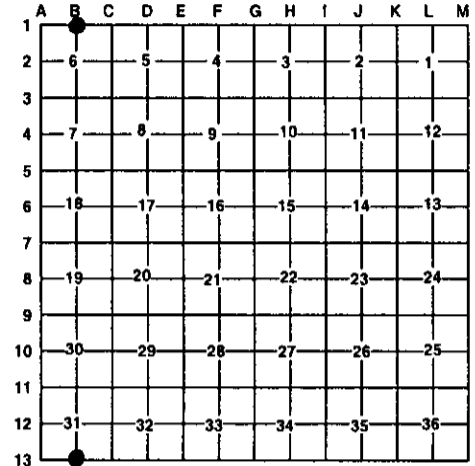

**A. Description of original monument and accessories and/or subsequent restoration:**

B13 & B1 – GLO – W. Pine 18" for corner – L. Lyon – 1850  
 Beech 10" North 8 L.

- M. Schaaf – 1933± - Index shows corner set by measurement.
- DNR corner record – 1951 – this corner had previously located and perpetuated by Marcus Schaaf. Burned over land, no original evidence remaining. 1 ¼" pipe with concrete base. 12" W. Oak N34°W 44 L.; 9" Oak N22°E 52 L. 6" R. Pine S7°W 70 L.

**B. Description of corner evidence found and/or method applies in restoring or re-establishing corner:**

B13 & B1 – Standard ¼ corner common to Sec. 31, T27N, R8W and Sec. 6, T26N, R8W – Fd. 1 ¼" I.D. iron pipe stub in concrete base per M. Schaaf buried in E-W firelane – 1'± S of centerline. Also found Schaaf witness pits 33' NW & SE. Schaaf Monument accepted as a careful and faithful reestablishment of the position of the original corner.

**C. Description of monument for corner and accessories established to perpetuate locating the position of the corner:**

B13 & B1 – Replaced Schaaf monument with 4" DOC (DNR) alum. cap on 1" x 24" galv. Iron pipe with 1' of 4" PVC with concrete around cap. – Down 0.5'  
 N25' to set Blue Carsonite Post with location tag.  
 N37°W 29.74' to set N & T in SW side 15" W. Oak (DNR)  
 N21°E 34.69' to set N & T in NW side 14" R. Oak (DNR)  
 S7°W 46.51' to set N & T in W side 12" R. Pine (DNR)  
 S59°E 33.10' to set N & T in N side 15" W. Pine scribed 'XBT'



Signed by: Craig W. McVean  
 Surveyor's Michigan License No.: 39088

Date: 12/12/2003