

LAND CORNER RECORDATION CERTIFICATE

Filing Requirement of Act 74, Mich. PA 1970



For Corners In:			
Kalkaska	Located In	Corner Code #	
(County)			
1. Public Land Survey	T <u>27N</u> R <u>8W</u>	<u>G7</u>	
	T _____ R _____	_____	_____
2. Property Controlling in Section	S _____ T _____ R _____	_____	_____
	S _____ T _____ R _____	_____	_____
3. Miscellaneous Property in Section	S _____ T _____ R _____	_____	_____
	S _____ T _____ R _____	_____	_____

4. Lot No: _____ Recorded Plat: _____

5. Private Claims: _____

I, Craig W. McVean, in a field survey on April 4, 2006 do hereby state that under requirements of PA 74, Michigan PA of 1970, the corner points mentioned in lines 1 and 2 above were in conformance with regulations and rules therefore as required in the current manual of survey instructions of the United States Department of the Interior, Bureau of Land Management or by a decree of a Court of Law and/or that the corner points mentioned in lines 3, 4 and 5 above were in conformance with the rules of the Michigan Board of Land Surveyors or by a Decree of a Court of Law; established, re-established, monumented, recovered, found as expressed below:

NOTE: Not more than 2 corners, all in the same town and range, may be recorded on this certificate.

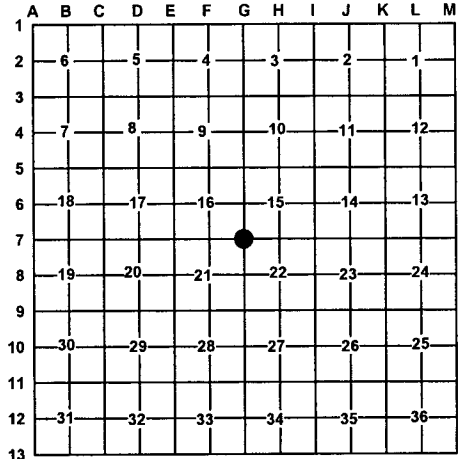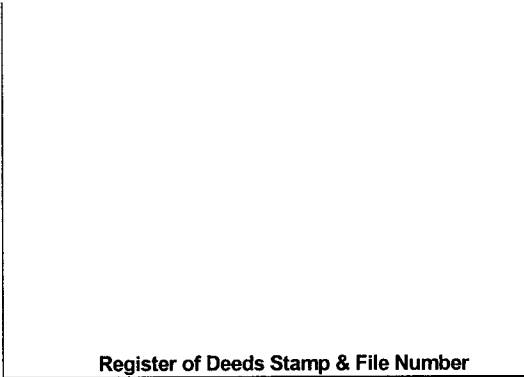

A. Description of original monument and accessories and/or subsequent restoration:

- | | |
|---|---|
| <p><u>G7</u> - GLO - Set Pine Post - L. Lyon - 1850
 Y. Pine 12" S82°E 55 L.
 W. Pine 16" N22°W 60 L.
 - CSR - L. 1, p. 52 and FB. 21, P. 78-80 - W. S. Merrill
 'G7' to 'H7' = 39.97 CH.
 - M. Schaaf - index shows original corner
 - DNR Corner Record - 1952
 Corner previously located and perp. by M. Schaaf. One original BT still in place, in poor condition.
 Set 1" pipe w/ 4" Brass Cap
 14" R. Oak S15°E 104 L.; 18" R. Oak N47°E 69 L.;
 12" W. Oak S42°W 82 L.</p> | <p>- LCRC - L. 2, p. 325 and Rec. Sur. - L 3, p. 141 - J. L. Wilcox - 1987 - Fd. DNR Mon. of record in CL. roads E, W and S. Two 1952 wit. in place.
 S55°W 15" Oak 53.13'; N22°W 6" Oak 52.14';
 N47°E 20" Oak (Face) 45.5' (OBT); S15°E 17" Tri. Oak (Face) 68.6' (OBT).
 - Rec. Survey - L. 4, p. 44 - J. Dean Geers - 1991
 Same Wit. as Wilcox LCRC.</p> |
|---|---|

B. Description of corner evidence found and/or method applied in restoring or re-establishing corner:

G7 - Sec. Cor. Common to Sec. 15, 16, 21, and 22 - Fd. Bent 1" x 3.5' long iron pipe w/ broken DNR Brass Cap in 'T' Gravel Rd. intersection. Straightened pipe and drove down. In CL. of E-W Gravel Rd. CL. of firelane S is 2± E. 1" iron pipe accepted as a careful and faithful perpetuation of the position of the original corner.

C. Description of monument for corner and accessories established to perpetuate locating the position of the corner:

G7 - Replaced 1" x 3.5' long iron pipe with 4" DOC (DNR) Brass Cap on 1" x 36" galv. iron pipe w/ coffee can w/ conc. around cap. - Down 0.7'
 North 33.02' to Fd. 1/2" CIR #14102 - Add Blue Carsonite Post w/ Loc. Tag.
 S58°E 53.82' to Fd. Nail in SW side 11" Oak
 S50°W 53.06' to set N & T in NW side 18" Oak (JLW)
 N28°W 52.15' to set N & T in NE side 11" Oak (JLW)
 N54°E 46.61' to Fd. Nail in SE side 22" Oak (KJO, JLW)



Signed by: Craig W. McVean
 Surveyor's Michigan License No.: 39088

Date: 6/5/2006