

LAND CORNER RECORDATION CERTIFICATE

Filing Requirement of Act 74, Mich. PA 1970

For Corners In: _____ Located In _____ Corner Code # _____
 Kalkaska _____
 (County)

1. Public Land Survey	T	27N	R	8W	E5
	T		R		
2. Property Controlling in Section	S		R		
	S		R		
3. Miscellaneous Property in Section	S		R		
	S		R		
	T		R		

4. Lot No: _____ Recorded Plat: _____
 5. Private Claims: _____

1. Craig W. McVean, in a field survey on July 8, 2003 do hereby state that under requirements of FRA 74, Michigan PA of 1970, the corner points mentioned in lines 1 and 2 above were in conformance with regulations and rules therefore as required in the current manual of survey instructions of the United States Department of the Interior, Bureau of Land Management or by a decree of a Court of Law and/or that the corner points mentioned in lines 3, 4 and 5 above were in conformance with the rules of the Michigan Board of Land Surveyors or by a Decree of a Court of Law; established, re-established, monumented, recovered, found as expressed below:

NOTE: Not more than 2 corners, all in the same town and range, may be recorded on this certificate.


1	A	B	C	D	E	F	G	H	I	J	K	L	M
2	6	5	4	3	2	1							
3													
4	7	8	9	10	11	12							
5	13	14	15	16	17	18	●						
6	19	20	21	22	23	24							
7													
8	25	26	27	28	29	30							
9													
10	31	32	33	34	35	36							
11													
12													
13													

Register of Deeds Stamp & File Number

- A. Description of original monument and accessories and/or subsequent restoration:
- E5 - GLO - L. Lyon - 1850 - Set Beech Post
 Hemlock 14" S03°E 25 L.
 Beech 14" N14°W 37 L.
 - CSR - FB # 39 - E.B. Dennis - Fd. one wit. tree and point of the old stake. Set new Cherry stake;
 Beech 4" S26 3/4°E 37 L.
 - SUGAR - FB, 7, P. 50 - W. S. Merrill - 1917 - notes cor.
 DNR Cor. Rec. - K. J. Ostling - 1967 - Fd. 1" pipe in line with centerline's of S & W road. Probably a restoration of early Co. surveyor's survey of Sec. 16. Appears acceptable
- as control for other corners in vicinity.
 Set 1" pipe with 4" Aluminum cap
 24" Hard Maple N20°W 25.8'
 18" White Pine S72°W 99.8'
 - Consumers Power Co. Drawing No. S-F 16878
 sheet 21, 1967 - Fd. 3/8" solid iron - 30" Maple N12°30'W 25.7'
 16" Beech S32°W 83.8' - 20" W. Pine S74°W 100.0'
 - LCRC - L. 2, p. 189 - J.L. Fletcher - 1979
 Fd. iron w/ DNR Disk
 Nail 26" Maple N16°W 26.13'
 Nail 20" Maple N58°W 53.2' Nail 6" Maple N62°E 35.91'

- B. Description of corner evidence found and/or method applied in restoring or re-establishing corner:
- E5 - Sec. Corner Common Sec. 8 & 9, 16 & 17 - Found broken 4" Department of Conservation Aluminum cap on 1" Iron pipe at centerline Pl of Dockery Road S & W, 26' East of Centerline private drive; N. 51± Northeast of Midpoint of curve on Dockery Rd. Dug down along monument and found 1" pipe noted by Ostling buried beside DOC (DNR) Mon. Broken DOC (DNR) Mon. accepted as the best available evidence of the position of the original corner.

- C. Description of monument for corner and accessories established to perpetuate locating the position of the corner:
- E5 - Replaced broken DOC Alum. cap and pipe w/ 4" DNR Alum. Cap on 1" x 36" Galv. iron pipe. Placed Fd. 1" pipe on West side as memorial. Added ring of cobblestones and gravel.
 Set Blue Carsonite Post with Location Tag 1' North.
 N18°W 26.69' to fd. nail in Southwest side 34" Maple (KJO, JLF, CPC)
 N14°W 23.85' to set N & T in East side 4" White Pine
 N18°E 19.81' to set N & T in East side 7" Red Oak
 N65°E 36.02' to found Nail in Northwest side 10" Sugar Maple (JLF)
 N82°E 34.20' to found Nail in North side 6" White Pine

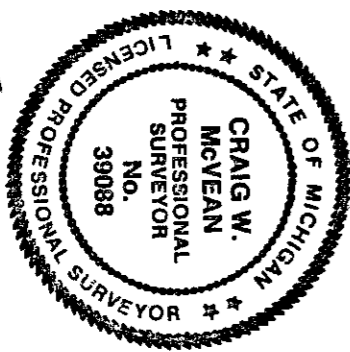

Signed by: Craig W. McVean Date: 12/16/2005
 Surveyor's Michigan License No.: 39088