

# LAND CORNER RECORDATION CERTIFICATE

## Filing Requirement of Act 74, Mich. PA 1970

For Corners In: \_\_\_\_\_ Located In \_\_\_\_\_ Corner Code # \_\_\_\_\_  
 Kalkaska \_\_\_\_\_  
 (County)

1. Public Land Survey	T	27N	R	8W	F5
	T	_____	R	_____	_____
2. Property Controlling in Section	S	_____	R	_____	_____
	S	_____	T	_____	_____
3. Miscellaneous Property in Section	S	_____	R	_____	_____
	S	_____	T	_____	_____

4. Lot No: \_\_\_\_\_ Recorded Plat: \_\_\_\_\_  
 5. Private Claims: \_\_\_\_\_

1. Craig W. McVean, in a field survey on July 31, 2003 do hereby state that under requirements of PA 74, Michigan PA of 1970, the corner points mentioned in lines 1 and 2 above were in conformance with regulations and rules therefore as required in the current manual of survey instructions of the United States Department of the Interior, Bureau of Land Management or by a decree of a Court of Law and/or that the corner points mentioned in lines 3, 4 and 5 above were in conformance with the rules of the Michigan Board of Land Surveyors or by a Decree of a Court of Law; established, re-established, monumented, recovered, found as expressed below:

**NOTE: Not more than 2 corners, all in the same town and range, may be recorded on this certificate.**

	A	B	C	D	E	F	G	H	I	J	K	L	M
1													
2	6	5	4	4	3	3	2	2	1	1			
3													
4	7	8	8	9	10	10	11	11	12				
5													
6	18	17	16	16	15	15	14	14	13				
7													
8	19	20	21	21	22	22	23	23	24				
9													
10	30	29	28	28	27	27	26	26	25				
11													
12	31	32	33	33	34	34	35	35	36				
13													

Register of Deeds Stamp & File Number


- A. Description of original monument and accessories and/or subsequent restoration:
- F5 - GLO - Set Sugar post for 1/4 Cor. - L. Lyon - 1850  
 Sugar 12" S83°W 23 L.  
 Hem. 24" NS3°E 33 L.
  - CSR - L. 1, p. 34 and FB. 25, p. 105-106 - W. S. Merrill - 1903  
 Sec. 16 Survey - Dist. S to 'F6' - 39.96 CH.
  - CSR - FB. #21, p. 61 - W. S. Merrill - 1907  
 Sec. 9 Survey - Dist. E to 'G5' - 40.16 CH
  - DNR Cor. Rec. - K. J. Ostling - 1967 - Set 1" pipe w/ 4" Alum. Cap by prop. measurement, midpoint on line between restored section corners. Nothing left for US
  - evidence or a previous corner:  
 7" J Pine S30°W 13.5'  
 10" B. Cherry N32°W 51.6'  
 - Rec. Sur. - L. 2, p. 853 - E. Farrier - 1984  
 Fd. DNR Mon. and Cedar post  
 Same Wtl. as Ostling.  
 - Untrec. Sur. - Farrier Surveying File #10701 - 2001 - E. D. Farrier Fd. DNR Mon.  
 Set Nail S35°W 14" J Pine 14.14'  
 Set Nail S71°W 5" J Pine 31.70'  
 Set Nail West 3" Ironwood 31.60'  
 Set Nail N35°W 8" W. Pine 21.97'

B. Description of corner evidence found and/or method applied in restoring or re-establishing corner:

F5 - 1/4 Corner common to Sec. 9 & 16 - Fd. 4" DOC (DNR) Alum. Cap on 1" Galv. iron pipe per Ostling and Farrier. Fd. Ostling J. Pine BT dead. No GLO or CSR evidence found. 4" DOC (DNR) Mon. accepted as a careful and faithful re-establishment of the position of the original corner.

C. Description of monument for corner and accessories established to perpetuate locating the position of the corner:

- F5 - 4" DOC (DNR) Alum. Cap on 1" iron pipe  
 Set blue carsonite post w/ Loc. tag 1' S  
 S30°W 14.00' to Fd. nail in SE side dead 12" J. Pine (KJO, EDF)  
 S64°W 31.51' to Fd. nail in SE side 6" J. Pine (EDF)  
 S89°W 31.61' to Fd. nail in SE side 5" ironwood (EDF)  
 N36°W 21.93' to Fd. nail in SW side 10" W. Pine (EDF)  
 S6°W 12.75' to set N & T in W side 4" Ironwood  
 N58°W 49.75' to set N & T in N side 4" White Pine Clp.-3

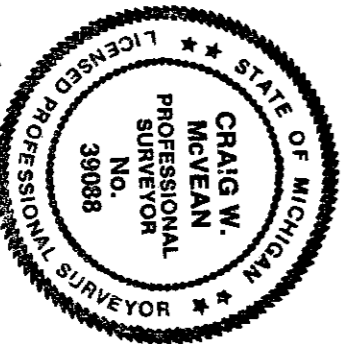

Signed by: Craig W. McVean Date: 12/16/2005  
 Surveyor's Michigan License No.: 39088