

LAND CORNER RECORDATION CERTIFICATE

Filing Requirement of Act 74, Mich. PA 1970

For Corners In: _____ Located In _____ Corner Code # _____
 Kalkaska _____
 (County)

1. Public Land Survey	T	27N	R	8W	G-5
	T	_____	R	_____	_____
2. Property Controlling in Section	S	_____	R	_____	_____
	S	_____	R	_____	_____
3. Miscellaneous Property in Section	S	_____	R	_____	_____
	S	_____	R	_____	_____

4. Lot No: _____ Recorded Plat: _____

5. Private Claims: _____

I, Craig W. McVean, in a field survey on NOV. 17, 2005 do hereby state that under requirements of PA 74, Michigan PA of 1970, the corner points mentioned in lines 1 and 2 above were in conformance with regulations and rules therefore as required in the current manual of survey instructions of the United States Department of the Interior, Bureau of Land Management or by a decree of a Court of Law and/or that the corner points mentioned in lines 3, 4 and 5 above were in conformance with the rules of the Michigan Board of Land Surveyors or by a Decree of a Court of Law, established, re-established, monumented, recovered, found as expressed below:

NOTE: Not more than 2 corners, all in the same town and range, may be recorded on this certificate.

	A	B	C	D	E	F	G	H	I	J	K	L	M
1													
2	6	5	4	3	2	1							
3													
4	7	8	9	10	11	12							
5													
6	18	17	16	15	14	13							
7													
8	19	20	21	22	23	24							
9													
10	30	29	28	27	26	25							
11													
12	31	32	33	34	35	36							
13													

Register of Deeds Stamp & File Number

A. Description of original monument and accessories and/or subsequent restoration:


- G-5 - GLO - L. Lyon - 1850 - Set sugar post
 Sugar 8" N28°E 9 L
 Sugar 10" S68°W 69 L
 - CSR - FB. 21, p. 62 - W.S. Merrill - 1903
 Noted corner - Dist. to 'F5' - 40.16 CH
 - M. Schraaf - 1933 - indicates original corner found.
 - DNR Cor. Rec. - K. J. Ostling - 1967 - Set 1" pipe w/
 4" Alum. Cap by double prop. measurement 1 mile W., 2
 miles E., 1 mile N., checked topo call to North.
 12" H. Maple S75°E 39.8'
 12" Hemlock S40°W 36.4'
- Consumers Power Co. Drawing # S-F16878 - Sheet 22
 Fd. 1" Iron - 1967
 12" Beech S65°30'E 28.4'
 12" Hemlock S46°30'W 36.5'
 8" B. Cherry S86°30'W 31.20'
 - Unrec. Surv - Farrer Surveying File # 5701 - E. Farrer -
 2001 - Fd. 1/2" iron rod 4" S. of Centerline of Road; Set
 Nail N69°E 8" Maple 33.97';
 Set nail S10°W 14" Maple 31.15';
 Set nail S44°W 15" Balsam 37.75';
 Set nail N14°W 14" Maple Clip. 20.19'

B. Description of corner evidence found and/or method applied in restoring or re-establishing corner:

- G-5 - Sec. Corner common to Sec. 8, 9, 10, 15 & 16 -
 Found 1/2" X 18" iron rebar near N. edge of E-W gravel Rd. Firs record bearing and distance to dying Hemlock closely.
 7' +/- N. of C/L E-W Gravel Rd. & 16.5' W of C/L of horse/foot trail. - N. Removed 1/2" x 18" iron rebar and find remains of old cedar guard post bottom on S. side of iron. No evidence of DNR Mon., which was probably obliterated by road widening or construction. Searched for evidence of Schraaf position but didn't find. Appears that 1/2" iron is within 1' ± of Ostlings position. 1/2" iron accepted as a careful and faithful re-establishment of the position of the original corner.

C. Description of monument for corner and accessories established to perpetuate locating the position of the corner:

- G-5 - Replaced 1/2" X 18" iron rebar with 4" DNR alum. cap on 1" X 36" Galv. Iron pipe with 1' of 4" PVC with concrete around cap - down 0.5'.
 S39°W 36.74' to found nail in NW side dying 15" Hemlock (KJO, CPC, EF)
 N20°W 20.20' to found nail in E side 11" R. Maple clip. of 4 (EF)
 N64°E 33.96' to set N&T in S side 10" S. Maple (EF)
 S4°W 31.13' to set N&T in W side 15" S. Maple (EF)
 S46°E 51.46' to set N&T in SW side 10" S. Maple scribed 'XBT'
 North 33' to set blue carsonite post with location tag.

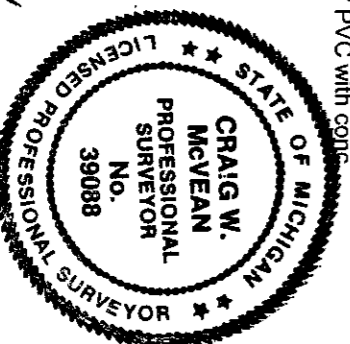

Signed by: Craig W. McVean Date: 12/16/2005
 Surveyor's Michigan License No.: 39088