

LAND CORNER RECORDATION CERTIFICATE

Filing Requirement of Act 74, Mich. PA 1970


For Corners In: Kalkaska Located In: _____ Corner Code # _____
 (County)

1. Public Land Survey	T	27N	R	8W	G6
	T		R		
2. Property Controlling in Section	S		R		
	S		R		
3. Miscellaneous Property in Section	S		R		
	S	T	R		

4. Lot No: _____ Recorded Plat: _____
 5. Private Claims: _____

I, Craig W. McVean, in a field survey on May 5, 2004 do hereby state that under requirements of PA 74, Michigan PA of 1970, the corner points mentioned in lines 1 and 2 above were in conformance with regulations and rules therefore as required in the current manual of survey instructions of the United States Department of the Interior, Bureau of Land Management or by a decree of a Court of Law and/or that the corner points mentioned in lines 3, 4 and 5 above were in conformance with the rules of the Michigan Board of Land Surveyors or by a Decree of a Court of Law; established, re-established, monumented, recovered, found as expressed below:

NOTE: Not more than 2 corners, all in the same town and range, may be recorded on this certificate.

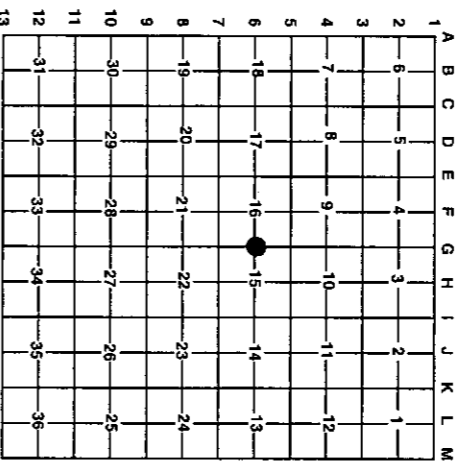

- A. Description of original monument and accessories and/or subsequent restoration:
- G6 - GLO - Set Pine Post - L. Lyon - 1850
 - Aspen 6" N09°W 69 L.
 - W. Pine 10" S33°E 12 L.
 - CSR - Lg. L., p. 15 & FB. #21, P. 78 -
 - W. S. Merrill - 1913 - Old cor. and Govt. BTs
 - P. S. 18" N70°E 20 1/2 L.
 - K.J. Ostling - 1967 - Fd. stake bottom - one probable USBT stp. remnants & Merrill's BT NE.
 - Set 1" pipe w/ 4" Alum. Cap
 - 12" W. Pine S05°W 32.8'
 - 5" W. Pine S75°E 51.9'
 - LCRC - L. 2, p. 325 - J. L. Wilcox - 1987
 - DNR Mon. found
 - S80°E 8" Cherry in clp. 37.94'
 - N70°E 6" W. Pine 10.73'
 - S38°W 28" W. Pine 35.94'
 - S75°E 8" W. Pine 52'
 - S05°W 16" W. Pine 32.5'

- B. Description of corner evidence found and/or method applied in restoring or re-establishing corner:
- G6 - 1/4 corner common to Section 16 & 15, T27N, R8W - Found 4" DOC (DNR) Aluminum Cap on 1" galv. Iron pipe per Ostling at Merrill's recovered GLO position. Found 4 out of 5 witness trees from Wilcox LCRC in 1987. DOC (DNR) Monument accepted as a careful and faithful perpetuation of the position of the original corner.

- C. Description of monument for corner and accessories established to perpetuate locating the position of the corner:
- G6 - 4" DOC (DNR) Alum. Cap on 1" galv. Iron pipe.
 - N65°E 10.70' to set N & T in S. side 12" W. Pine (JLW)
 - S84°E 38.00' to find nail in S. side 10" Cherry (JLW)
 - S78°E 52.07' to set N & T in N. side 12" W. Pine (JLW, KJO)
 - S03°W 33.40' to set N & T in W. side 18" W. Pine (JLW, KJO)
 - S78°W 11.39' to found nail in S. side 6" W. Pine
 - N13°W 27.82' to set N & T in W. side 8" triple R. Maple
 - Set blue carsonite post 1" NE



Signed by: Craig W. McVean Date: 12/16/2005
 Surveyor's Michigan License No.: 39088