

LAND CORNER RECORDATION CERTIFICATE

FILING REQUIREMENT OF ACT 74, MICH. P.A.1970

FOR CORNERS OF--:	LOCATED IN--:	CORNER CODE NUMBER
1. PUBLIC LAND SURVEY _____	T. 28 N. R. 6 W.	A-12; A-13; B-13; C-12; C-13
2. PROPERTY CONTROLLING IN SECTION _____	T. _____ N. S., R. _____ E. W.	_____
3. MISCELLANEOUS PROPERTY IN SECTION _____	T. _____ N. S., R. _____ E. W.	_____
4. LOT NO. _____, RECORDED PLAT _____		
5. PRIVATE CLAIMS _____		

REGISTER OF DEEDS STAMP AND FILING NUMBER

I, Carl F. Roser, do hereby certify that under requirements of P.A. 74, Michigan P.A. of 1970, the corner points mentioned in lines 1 and 2 above were, in a field survey on December 16, 1976, established, re-established, monumented, re-monumented, recovered or restored as expressed below and in conformance with regulations and rules therefore as required in the current manual of survey instructions of the United States Department of the Interior, Bureau of Land Management or by a decree of a court of law. Furthermore, that the corner points mentioned in lines 3, 4 and 5 above were, in a field survey on _____, 19____, found, recovered, restored, established or re-established as expressed below and in conformance with the rules of the Michigan State Board of Registration for Land Surveyors or, by a Decree of a Court of law:

~~A - Description of original monument and accessories and/or subsequent restoration -~~

C. (continued)

	Fd.	C-12	C-13
	5/8"x18" rerod & set cedar post w/loc. tag		Set 1"x18" rod over old 1 1/2" pipe
	7" Poplar	S02°W 9.22	28" Maple S48°E 48.16
	5" Maple	N25°E 20.06	10" Maple N47°W 48.63
	4" Maple	S85°E 19.27	9" Maple N13°W 27.72
	6" Maple	S70°W 7.47	Set cedar post w/loc. tag
			Due N 33'

- B. Description of corner evidence found and/or method applied in restoring or re-establishing corner:
- A-12 Reestablished 1/4 corner S.P.
 - A-13 Fd. 3/4" pipe as recovered for SE Sec. 36 (28N-7W) by L. Gerschbacher in 1974.
 - B-13 Reestablished 1/4 corner on line & at prorated dist. to US between SE & SW corners of S-31.
 - C-12 Found rerod by RLS A. V. Courtright.
 - C-13 Fd. 1/2" rerod over 1 1/2" pipe. Rerod by A.V. Courtright; removed same & replaced with 1"x18" iron rod. Corner is in approximate center of dirt Co. Rd. intersection E-W-S.


C. Description of monument for corner and accessories established to perpetuate locating the position of the corner:

A-12	A-13	B-13
Set DNR mon. & cedar post	Fd. 3/4" pipe & set DNR mon. & cedar post	Set 1 1/2"x24" Rod
14" Y. Birch N58°W 16.5	9" Cedar S69°W 35.5	7" Cedar N17°E 18.68
10" Maple S42°W 10.6	10" Cedar S42°W 25.2	7" Apple N45°E 31.00
9" Y. Birch Due E 19.6	12" Cedar S17°W 19.4	18" Apple S26°W 68.30
6" Beech N44°E 12.7	10" Cedar S35°W 38.6	Ctr. E-W dirt rd. Due S 9'±
	Ctr. E-W swp. road	Set cedar post w/loc. tag
	Due N 7'±	Due N 33'

SIGNED BY Carl F. Roser

DATE 10-31-77

SURVEYOR'S MICHIGAN REGISTRATION NO. 12028

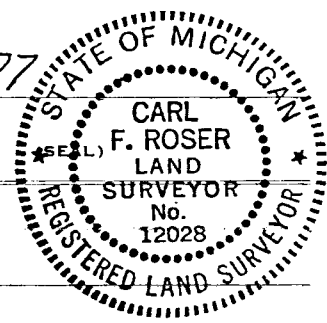

FOR STATE AND UNITED STATES AGENCIES:

SIGNED BY _____ DATE _____

APPROVED AND SIGNED BY _____ DATE _____

SURVEYOR'S MICHIGAN REGISTRATION NO. _____

COLD SPRINGS TOWNSHIP
KALKASKA COUNTY

MAY PLACE SKETCH ON BACK OR ATTACHED SHEET