

LAND CORNER RECORDATION CERTIFICATE

FILING REQUIREMENT OF ACT 74, MICH. P.A.1970

FOR CORNERS OF--:	LOCATED IN--:	CORNER CODE NUMBER
1. PUBLIC LAND SURVEY	T. 28 ^{N.} <input checked="" type="radio"/> , R. 7 ^{W.} <input checked="" type="radio"/>	K-9; K-10
2. PROPERTY CONTROLLING IN SECTION 25	T. 28 ^{N.} <input checked="" type="radio"/> , R. 7 ^{W.} <input checked="" type="radio"/>	1; 3
3. MISCELLANEOUS PROPERTY IN SECTION 25	T. 28 ^{N.} <input checked="" type="radio"/> , R. 7 ^{W.} <input checked="" type="radio"/>	*** (1/2 way between code 4 & 8, 656.74 S00°23'26"W of ctr. of NW 1/4 S25)
4. LOT NO. _____	RECORDED PLAT _____	
5. PRIVATE CLAIMS _____		

REGISTER OF DEEDS STAMP AND FILING NUMBER

I, Carl F. Roser, do hereby certify that under requirements of P.A. 74, Michigan P.A. of 1970, the corner points mentioned in lines 1 and 2 above were, in a field survey on May 14, 1976, established, re-established, monumented, re-monumented, recovered or restored as expressed below and in conformance with regulations and rules therefore as required in the current manual of survey instructions of the United States Department of the Interior, Bureau of Land Management or by a decree of a court of law. Furthermore, that the corner points mentioned in lines 3, 4 and 5 above were, in a field survey on May 10, 1976, found, recovered, restored, established or re-established as expressed below and in conformance with the rules of the Michigan State Board of Registration for Land Surveyors or, by a Decree of a Court of law:

~~A. Description of original monument and accessories and/or subsequent restoration.~~

C. (continued)

3	***
Set 1 1/4"x20" Rod	Set 1/2"x5/8"x4.5' bar & cedar post w/loc. tag
8" B.Cherry N84°E 77.0	4" Oak N73°E 10.0
8" B.Cherry N26°E 35.0	8" Maple N43°W 46.0
6" B.Cherry N52°W 75.0	6" Cherry S79°W 29.1
Set cedar post w/loc. tag	4" Oak Due S 27.4
Due E 33'	
Ctr. N-S dirt rd. Due W 17'±	Fd. 1 1/4" pipe S42°14'55"W 11.93

- B. Description of corner evidence found and/or method applied in restoring or re-establishing corner:
- K-9 Found iron pipe & sug. witness tree NE as called for in B.L.Caukins survey dated 1919. Corner falls in approximate center of dirt road intersection N-E-W with center of road to south being 14'± to west.
 - K-10 Reestablished 1/4 corner S.P.
 - 1 Established 1/16 corner S.P.
 - 3 Established 1/16 corner per standard survey procedure.
 - *** Established NE corner of SE 1/4-SW 1/4-NW 1/4 of Sec. 25 per standard B.L.M. instructions.

C. Description of monument for corner and accessories established to perpetuate locating the position of the corner:

K-9	K-10	1
Fd. 1" pipe & plow land side iron	Set DNR mon. & cedar post	Set 1 1/4"x20" iron rod
30" Maple N50°E 51.64	6" Maple S41°E 47.1	22" Maple N13°W 58.41
(old B.T.)	14" B.Cherry N03°E 88.7	24" Maple S81°W 82.72
24" Maple S10°E 103.96	8" B.Cherry N89°E 90.3	12" B.Cherry S04°W 82.35
18" Maple S53°E 151.70	Ctr. N-S dirt rd. Due W 18'±	Set cedar post w/loc. tag
Set cedar post w/loc. tag	Entr. dirt rd. to E	Due S 33'
S45°E 47'	Due S 60'±	


SIGNED BY Carl F. Roser DATE 10-31-77

SURVEYOR'S MICHIGAN REGISTRATION NO. 12028

FOR STATE AND UNITED STATES AGENCIES:

SIGNED BY _____ DATE _____

APPROVED AND SIGNED BY _____ DATE _____

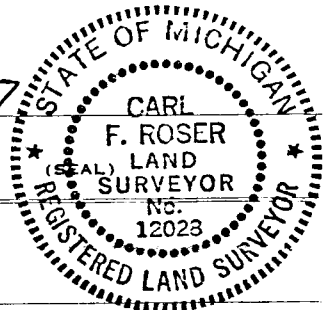

RAPID RIVER TOWNSHIP
KALKASKA COUNTY

SURVEYOR'S MICHIGAN REGISTRATION NO. _____