

LAND CORNER RECORDATION CERTIFICATE

FILING REQUIREMENT OF ACT 74, MICH. P.A.1970

FOR CORNERS OF--:	LOCATED IN--:	CORNER CODE NUMBER
1. PUBLIC LAND SURVEY _____	T. <u>28</u> ^{N.} <u>●</u> , R. <u>7</u> ^{W.} <u>●</u>	K-11; L-11; M-10; M-11
2. PROPERTY CONTROLLING IN SECTION _____	, T. _____, ^{N.} S., R. _____, ^{E.} W.	_____
3. MISCELLANEOUS PROPERTY IN SECTION <u>24</u>	, T. <u>28</u> ^{N.} <u>●</u> , R. <u>7</u> ^{W.} <u>●</u>	YY (1978.34 E of K-9 & 659.44 W of L-9)
4. LOT NO. _____	, RECORDED PLAT _____	
5. PRIVATE CLAIMS _____		

REGISTER OF DEEDS STAMP AND FILING NUMBER

I, Carl F. Roser, do hereby certify that under requirements of P.A. 74, Michigan P.A. of 1970, the corner points mentioned in lines 1 and 2 above were, in a field survey on May 12, 1976, established, re-established, monumented, re-monumented, recovered or restored as expressed below and in conformance with regulations and rules therefore as required in the current manual of survey instructions of the United States Department of the Interior, Bureau of Land Management or by a decree of a court of law. Furthermore, that the corner points mentioned in lines 3, 4 and 5 above were, in a field survey on May 12, 1977, found, recovered, restored, established or re-established as expressed below and in conformance with the rules of the Michigan State Board of Registration for Land Surveyors or, by a Decree of a Court of law:

~~A. Description of original monument and accessories and/or subsequent restoration~~

C. (continued)

	M-11		YY
Fd. 3/4" rerod & set DNR mon. & cedar post			Drove 1 1/4"x18" Iron Rod
20" W. Pine	N09°W 57.63		5" Maple N19°W 43.62
14" Maple	S58°W 55.20		P. Pole N10°E 45.25
9" W. Pine	S05°E 62.4		Cherry Clmp. S19°E 86.02
Ctr. old E-W rd. grade Due S 10'±			Set cedar post w/loc. tag Due N 33'
Fd. "T" Iron	S46°12'E 8.09		Ctr. E-W gravel rd. Due N 9'±

- B. Description of corner evidence found and/or method applied in restoring or re-establishing corner:
- K-11 Found 3/4" pinch pipe & stone; approximate intersection of sand roads N-S-E-W is 10' S.
 - L-11 Reestablished 1/4 corner S.P.
 - M-10 Found 5/8" rerod by RLS Larry Gerschbacher (Shell Oil).
 - M-11 Fd. 3/4"x30" rerod in wet swampy area by RLS L. Gerschbacher (Shell Oil) who found sq'd. cedar post as recovered by A.V. Courtright in 1972. (See cor. code A-11, T28N-R6W, L. Gerschbacher, April 21, 1975).
 - YY Established SE corner of W 1/2-SE 1/4-SW 1/4 of Sec. 24 per std. B.L.M. instructions.

C. Description of monument for corner and accessories established to perpetuate locating the position of the corner:

	K-11	L-11		M-10
Fd. 3/4"x18" pinch pipe & set 1 1/4"x2' rod		Set DNR mon. & cedar post		Fd. rerod & set DNR mon. & cedar post
6" Maple	S21°E 121.8	14" B.Cherry N05°E 102.8		8" Y.Birch N12°E 20.51
6" Cherry	N73°E 86.0	14" Tri-Cherry N77°E 54.4		10" Maple S21°E 30.92
6" Cherry	S24°W 109.7	12" B.Cherry S37°W 148.0		12" Beech S37°W 28.10
Set cedar post w/loc. tag N45°E 47'				8" Maple N40°W 29.35

SIGNED BY Carl F. Roser

DATE 10-31-77

SURVEYOR'S MICHIGAN REGISTRATION NO. 12028


FOR STATE AND UNITED STATES AGENCIES:

SIGNED BY _____ DATE _____

CHIEF OF SURVEY PARTY

APPROVED AND SIGNED BY _____ DATE _____

MICHIGAN REGISTERED LAND SURVEYOR

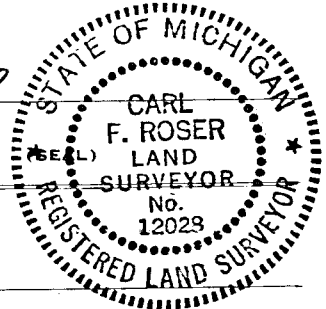

(SEAL)

SURVEYOR'S MICHIGAN REGISTRATION NO. _____

RAPID RIVER TOWNSHIP
KALKASKA COUNTY