

LAND CORNER RECORDATION CERTIFICATE

FILING REQUIREMENT OF ACT 74, MICH. P.A.1970

FOR CORNERS OF --:	LOCATED IN --:	CORNER CODE NUMBER
1. PUBLIC LAND SURVEY _____	T. <u>28</u> N. R. <u>7</u> W.	M-8; M-9
2. PROPERTY CONTROLLING IN SECTION <u>24</u>	T. <u>28</u> N. R. <u>7</u> W.	7; 14
3. MISCELLANEOUS PROPERTY IN SECTION <u>24</u>	T. <u>28</u> N. R. <u>7</u> W. and S00°30'W 662.47 from M-8)	XX (between M-8 & M-9)
4. LOT NO. _____, RECORDED PLAT _____		
5. PRIVATE CLAIMS _____		

REGISTER OF DEEDS STAMP AND FILING NUMBER

I, Carl F. Roser, do hereby certify that under requirements of P.A. 74, Michigan P.A. of 1970, the corner points mentioned in lines 1 and 2 above were, in a field survey on May 12, 1977, established, re-established, monumented, re-monumented, recovered or restored as expressed below and in conformance with regulations and rules therefore as required in the current manual of survey instructions of the United States Department of the Interior, Bureau of Land Management or by a decree of a court of law. Furthermore, that the corner points mentioned in lines 3, 4 and 5 above were, in a field survey on May 12, 1977, found, recovered, restored, established or re-established as expressed below and in conformance with the rules of the Michigan State Board of Registration for Land Surveyors or, by a Decree of a Court of law:

~~A. Description of original monument and accessories and/or subsequent restoration:~~

C. (continued)	14	XX
	Drove 1 1/4"x24" Rod	Drove 5/8"x36" Rerod
	P.Pole N83°E 51.60	P.Pole N33°E 86.45
	8" Cherry N35°W 82.04	28" Maple S55°E 115.83
	17" Twn.Cherry S50°W 66.15	9" Cherry N72°W 82.92
	Set cedar post w/loc. tag	Set ced.post w/loc. tag Due W 33'
	Due W 33'	Ctr. N-S dirt road Due W 3'

B. Description of corner evidence found and/or method applied in restoring or re-establishing corner:

- M-8 Found 1/2" rerod by RLS C. Hughes.
- M-9 Found 1/2" rerod with RLS Cap #16939, Norm Parker; replaced with DNR monument.
- 7 Established 1/16 corner per std. BLM instructions. Corner falls 4'± E of E edge of N-S dirt road, is in line w/old tree row & fence (down) to W and tree row to S.
- 14 Established 1/16 corner S.P.; corner falls in approximate ctr. of N-S sand & gravel road.
- XX Established SE corner of NE 1/4-NE 1/4-SE 1/4 of Sec. 24 per std. B.L.M. instructions.

C. Description of monument for corner and accessories established to perpetuate locating the position of the corner:

M-8	M-9	7
Fd. 1/2"x18" rerod w/cap - add 1"x36" pipe	Set DNR mon. & cedar post	Drove 5/8"x36" rerod w/plastic cap; set ced. post w/loc. tag
Cherry Clmp. S53°W 90.72	12" B.Cherry S51°E 56.90	15" Cherry S66°E 88.25
P. Pole N17°E 150.50	8" Maple S09°W 36.40	18" Cherry N61°W 79.56
Set cedar post w/loc. tag	30" Beech S61°W 26.69	8" Maple N65°E 113.63
Due W 47'	12" W. Pine N30°E 84.48	⊕ N-S sand road Due W 20'
Ctr. N-S dirt road Due W 14'±		

SIGNED BY Carl F. Roser

DATE 10-31-77

SURVEYOR'S MICHIGAN REGISTRATION NO. 12028


FOR STATE AND UNITED STATES AGENCIES:

SIGNED BY _____ DATE _____

CHIEF OF SURVEY PARTY

APPROVED AND SIGNED BY _____ DATE _____

MICHIGAN REGISTERED LAND SURVEYOR

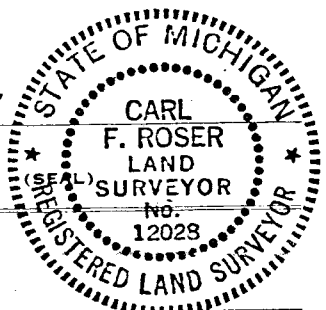

(SEAL)

SURVEYOR'S MICHIGAN REGISTRATION NO. _____

RAPID RIVER TOWNSHIP
KALKASKA COUNTY