

LAND CORNER RECORDATION CERTIFICATE

FILING REQUIREMENT OF ACT 74, MICH. P.A.1970

FOR CORNERS OF--:	LOCATED IN--:	CORNER CODE NUMBER
1. PUBLIC LAND SURVEY _____	T. <u>28</u> N. <input checked="" type="radio"/> R. <u>7</u> W. <input checked="" type="radio"/>	G-5; H-5; I-5; J-5
2. PROPERTY CONTROLLING IN SECTION _____	, T. _____ N. <input type="radio"/> S. <input type="radio"/> R. _____ E. <input type="radio"/> W. <input type="radio"/>	_____
3. MISCELLANEOUS PROPERTY IN SECTION <u>14</u>	, T. <u>28</u> N. <input checked="" type="radio"/> R. <u>7</u> W. <input checked="" type="radio"/>	ZZ (on line between K-5 & K-6 & 297.17' N of K-6)
4. LOT NO. _____	RECORDED PLAT _____	
5. PRIVATE CLAIMS _____		

REGISTER OF DEEDS STAMP AND FILING NUMBER

I, Carl F. Roser, do hereby certify that under requirements of P.A. 74, Michigan P.A. of 1970, the corner points mentioned in lines 1 and 2 above were, in a field survey on June 2, 1977, established, re-established, monumented, re-monumented, recovered or restored as expressed below and in conformance with regulations and rules therefore as required in the current manual of survey instructions of the United States Department of the Interior, Bureau of Land Management or by a decree of a court of law. Furthermore, that the corner points mentioned in lines 3, 4 and 5 above were, in a field survey on May 13, 1977, found, recovered, restored, established or re-established as expressed below and in conformance with the rules of the Michigan State Board of Registration for Land Surveyors or, by a Decree of a Court of law:

~~A. Description of original monument and accessories and of subsequent restoration.~~

C. (continued)

	J-5	ZZ
Found 1/2" rerod		Drove 1 1/4"x18" Iron
6" S. Pine	N33°W 61.50	6" Maple S35°W 29.3
6" S. Pine	N31°E 53.18	3" Ironwood S72°W 20.7
3" S. Pine	S42°E 65.34	4" Maple N36°W 26.6
Fd. 1/2" rerod	Due N 33.00	Set cedar post w/loc. tag
Set cedar post w/loc. tag	Due N 33.0	Due W 16.5

- B. Description of corner evidence found and/or method applied in restoring or re-establishing corner:
- G-5 Fd. conc. sub'n. mon. (flush) on hummock of dirt at edge of dirt inters.; SE corner of plat of "Rapid River Campsites" Liber C of plats pp. 13-14-15-16.
 - H-5 Fd. 1/2" pipe as recovered by L.Czubek RLS #12581 in 1974; see cert. survey Liber 1, p. 481. Corner falls at approximate intersection of roads to N-E-W.
 - I-5 Found 1/2" iron in mon. box as accepted by RLS J. Wilcox.
 - J-5 Found 1/2" rerod as established by RLS J. Wilcox.
 - ZZ Estab. NE corner of S 9 acres of SE 1/4-NE 1/4 of Sec. 14 per std. section sub'n. & at a record 9.000 acres. Old corner fence post w/fence N & W is 7'± W. Old N-S R-O-W fence is 25.5'± E corner falls in center of old N-S trail road.

C. Description of monument for corner and accessories established to perpetuate locating the position of the corner:

	G-5	H-5		I-5
Fd. Concrete Sub'n. Monument		Found 1/2" Pipe		Fd. 1/2" Iron in Monument Box
10" Maple	N42°E 27.72	14" Elm Stump	S08°E 10.29	P. Pole N12°W 109.35
12" Basswood	N60°E 4.53	P. Pole	N41°W 47.03	P. Pole S18°W 113.70
5" Maple	S38°E 46.59	6" W. Pine	N34°E 86.11	Exp. Joint Ctr. US-131 N'ly 84.7
6" Maple	S05°E 32.85			Exp. Jt. Ctr. US-131 S80°W 30.2
Ctr. of narrow E-W dirt rd.				Ctr. Pvt. US-131 Due W 25.1
Due S 6'±				Set cedar post w/loc. tag
Ctr. dirt rd. to N	Due W 20'±			S45°E 60'


SIGNED BY Carl F. Roser DATE 10-31-77

SURVEYOR'S MICHIGAN REGISTRATION NO. 12028

FOR STATE AND UNITED STATES AGENCIES:

SIGNED BY _____ DATE _____
CHIEF OF SURVEY PARTY

APPROVED AND SIGNED BY _____ DATE _____
MICHIGAN REGISTERED LAND SURVEYOR

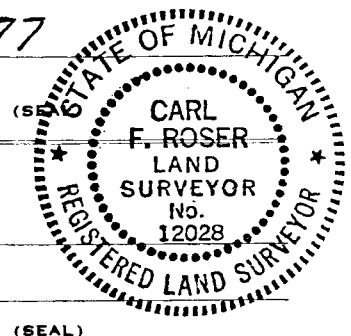

RAPID RIVER TOWNSHIP
KALKASKA COUNTY

SURVEYOR'S MICHIGAN REGISTRATION NO. _____

MAY PLACE SKETCH ON BACK OR ATTACHED SHEET