

# LAND CORNER RECORDATION CERTIFICATE

## FILING REQUIREMENT OF ACT 74, MICH. P.A.1970

FOR CORNERS OF--:	LOCATED IN--:	CORNER CODE NUMBER
1. PUBLIC LAND SURVEY _____	T. <u>28</u> N. <u>7</u> R. <u>W.</u>	<u>I-6; I-7; J-6; J-7</u>
2. PROPERTY CONTROLLING IN SECTION _____	T. _____ N. _____ S. _____ R. _____ E. _____ W. _____	_____
3. MISCELLANEOUS PROPERTY IN SECTION _____	T. _____ N. _____ S. _____ R. _____ E. _____ W. _____	_____
4. LOT NO. _____, RECORDED PLAT _____		
5. PRIVATE CLAIMS _____		

REGISTER OF DEEDS STAMP AND FILING NUMBER

I, Carl F. Roser, do hereby certify that under requirements of P.A. 74, Michigan P.A. of 1970, the corner points mentioned in lines 1 and 2 above were, in a field survey on May 16, 1977, established, re-established, monumented, re-monumented, recovered or restored as expressed below and in conformance with regulations and rules therefore as required in the current manual of survey instructions of the United States Department of the Interior, Bureau of Land Management or by a decree of a court of law. Furthermore, that the corner points mentioned in lines 3, 4 and 5 above were, in a field survey on \_\_\_\_\_, 19\_\_\_\_, found, recovered, restored, established or re-established as expressed below and in conformance with the rules of the Michigan State Board of Registration for Land Surveyors or, by a Decree of a Court of law:

~~=====~~

C. (continued)

J-7

Set DNR monument & cedar post		
8" Twn. Maple	N54°E	22.6
17" Maple	N21°W	63.4
8" Maple	S63°E	56.1

B. Description of corner evidence found and/or method applied in restoring or re-establishing corner:


- 6 Found 1½" pipe from W. S. Merrill wit. (14" Elm now 30", N53½'E, 47½ ft.). Pipe is surrounded w/broken cast iron & a stone on W side of iron. Pipe raised w/½"rerod.
- 7 Accepted ½" rerod w/plastic RLS cap, Corey Hughes, as placed over fd. old ¾" pipe on S side of old 4" ced. post, 22" deep, in ctr. of N-S gravel rd. Old fence remains to W.
- 6 Established center of Sec. 14 at intersection of ¼ lines. Old corner fence post with fence remains N-S-E-W is 18' West.
- 7 Reestablished ¼ corner per C.P.C. survey of Sec. 23 in 1967; that is, on line and double distance across found 1/8 corner and section corner to East.

C. Description of monument for corner and accessories established to perpetuate locating the position of the corner:

	I-6		I-7		J-6
<i>set</i> ½" Rerod over fd. 1½" pipe.			<i>Fd.</i> ½" Rerod		
36" Elm	N55°E 48.30		8" W. Pine	S58°W 62.6	Drove 1"x36" pipe w/plastic cap & set cedar post w/loc. tag
P. Pole	S33°W 49.38		9" Cedar	N65°W 69.0	17" Twn. Cherry S35°W 10.1
8" Maple	N74°W 56.20		10" Tamarack	S88°E 26.4	24" Maple S59°E 42.3
Ctr. N-S gravel rd. Due E 4'±			Set ced. post w/loc. tag		12" Maple S11°E 44.3
Ctr. RR tracks Due S 83'±				Due E 33'	
Set cedar post w/loc. tag			1½" pipe as fd. & wit. by CPC		
Due E 33'			S88°37'W 22.5		
			Ctr. Rapid Rvr. C-W Due N 117'±		

SIGNED BY Carl F. Roser DATE 10-31-77

SURVEYOR'S MICHIGAN REGISTRATION NO. 12028

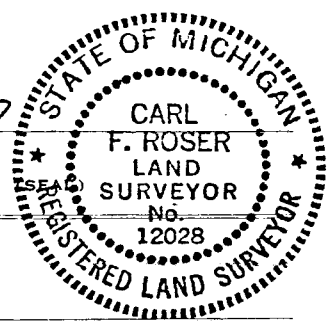

FOR STATE AND UNITED STATES AGENCIES:

SIGNED BY \_\_\_\_\_ DATE \_\_\_\_\_  
CHIEF OF SURVEY PARTY

APPROVED AND SIGNED BY \_\_\_\_\_ DATE \_\_\_\_\_  
MICHIGAN REGISTERED LAND SURVEYOR

(SEAL)

SURVEYOR'S MICHIGAN REGISTRATION NO. \_\_\_\_\_  
 RAPID RIVER TOWNSHIP  
 KALKASKA COUNTY