

SEC. 7; KALKASKA & ANTRIM Co.

LAND CORNER RECORDATION CERTIFICATE

FILING REQUIREMENT OF ACT 74, MICH. P.A. 1970

FOR CORNERS OF--	LOCATED IN--	CORNER CODE NUMBER
1. PUBLIC LAND SURVEY _____	T. 28 N. S. , R. 8 E. W.	B-3 B-5 C-3
2. PROPERTY CONTROLLING IN SECTION 7 _____	T. 28 N. S. , R. 8 E. W.	Code 7
3. MISCELLANEOUS PROPERTY IN SECTION _____	T. _____ N. S. , R. _____ E. W.	
4. LOT NO. _____, RECORDED PLAT _____		
5. PRIVATE CLAIMS _____		

REGISTER OF DEEDS STAMP AND FILING NUMBER

I, Carl F. Roser do hereby certify that under requirements of P.A. 74, Michigan P.A. of 1970, the corner points mentioned in lines 1 and 2 above (identified with circles on index code diagram - over) were, in a field survey on 12-28 1972, established, re-established, monumented, re-monumented, recovered or restored as expressed below and in conformance with regulations and rules therefore as required in the current manual of survey instructions of the United States Department of the Interior, Bureau of Land Management or by a decree of a court of law. Furthermore, that the corner points mentioned in lines 3, 4 and 5 above were, in a field survey on _____ 19____, found, recovered, restored, established or re-established as expressed below and in conformance with the rules of the Michigan State Board of Registration for Land Surveyors or, by a Decree of a Court of law:

A. Description of original monument and accessories and/or subsequent restoration:

B. Description of corner evidence found and/or method applied in restoring or re-establishing corner:

- B-3 Reestablished corner per std. B.L.M. instructions. Corner falls among tree stumps in flooded area.
- B-5 Recovered square Cedar stake. Old corner of record, Merrill 1923, Botsford 1944.
- C-3 Recovered iron in river. Old accepted corner of record.
- Code 7 Established corner per standard B.L.M. instructions.

C. Description of monument for corner and accessories established to perpetuate locating the position of the corner:

B-3	B-5	Code 7
Set 1 1/4" x 72" pipe w/Dept Cap w/Ced Gd. Post	Fd. Stake. Added 1" x 6' pipe w/alum Dept. Cap.	Set DNR Con Mon w/St fn Post
10" W. Pine N84W 92.49'	5" Tamarack N82W 18.7'	12" W. Pine N80E 55.3'
12" Hemlock S68W 43.05'	9" W. Pine Due S 34.5'	8" W. Pine S13E 19.9'
P. Pole S48W 82.70'	9" Cedar S57E 45.0'	5" W. Pine S64W 21.3'
		Exist. 1 1/2" pipe N72W 15.0'
		Exist. Con. Mon N84W 14.3'
C-3		
Fd. Iron Buggy axle		
9" Cedar S 5W 33.3'		
12" Cedar S14E 45.29'		
11" Cedar S36E 47.97'		


SIGNED BY Carl F. Roser DATE 6-15-73

SURVEYOR'S MICHIGAN REGISTRATION NO. 12028

FOR STATE AND UNITED STATES AGENCIES:

SIGNED BY _____ CHIEF OF SURVEY PARTY

APPROVED AND SIGNED BY _____ MICHIGAN REGISTERED LAND SURVEYOR

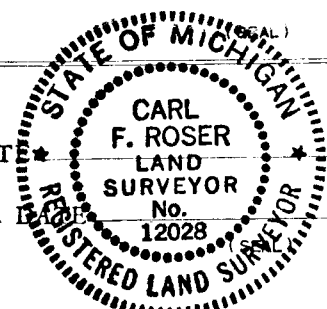

SURVEYOR'S MICHIGAN REGISTRATION NO. _____