

MICHIGAN
DEPARTMENT OF CONSERVATION
FORESTRY DIVISION

LAND CORNER RECORD

T. 28 N.R. 5 W


Kalkaska COUNTY

DESCRIPTION OF CORNER Sec. corner common to Sections 27-28-33-34

CORNER MONUMENT Left 1/2 x 2" iron bar in place. Raised with 8" of 1 1/4" pipe.

DATE MONUMENT PLACED AND WITNESSED 2/8/68

WITNESSES TO CORNER.....

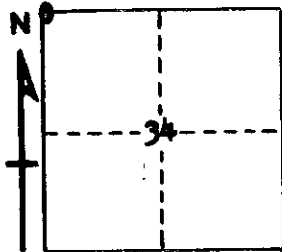

CIRCLE CORNER REGISTERED

6" H. Maple S 62 W 64.7


5" H. Maple N 45 W 57.0

AND

DESCRIPTION IN DETAIL AS TO HOW CORNER WAS LOCATED AND IDENTIFIED OR RESTORED.

This corner was found during a retracement survey in this area. Located iron bar and old stake bottom about 10" below surface of road. Local resident Reed Brown used this corner to establish NW fence corner. Appears acceptable for proper location by measurements also.

SURVEYOR'S SEAL

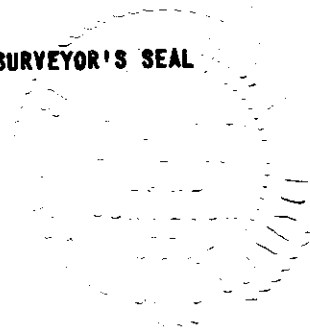

SIGNED *Conrad Wetling* DATE 2/15/68
REGISTERED LAND SURVEYOR #10068