

MICHIGAN
DEPARTMENT OF CONSERVATION
FORESTRY DIVISION

LAND CORNER RECORD

T. 28 N.R. 5 W


KALKASKA COUNTY

DESCRIPTION OF CORNER Sec. corner common to sections 21-22-27-28

CORNER MONUMENT Left Conc. Mon. in place.

DATE MONUMENT PLACED AND WITNESSED 6-17-69

WITNESSES TO CORNER..... Bolt in 30" Pine Stp N 57 E 66.0

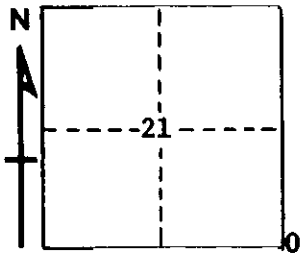

CIRCLE CORNER REGISTERED

" " 30" Pine Stp N 43 W 54.8

" " 10" W. Birch South 51.2

AND

DESCRIPTION IN DETAIL AS TO HOW CORNER WAS LOCATED AND IDENTIFIED OR RESTORED.

This corner was found and accepted during retracement in this area. Found 4" concrete monument at corner which we conclude perpetuates B.L. Caukins corner as established in 1919 survey in this township. One Caukins witness in place NW. A 1/2" pipe is located about 3' North and 9' West of restored corner, but can find no support for this location.

SURVEYOR'S SEAL

SIGNED *Kenneth J. Ostling* DATE 6-24-69
REGISTERED LAND SURVEYOR #10068