

MICHIGAN  
DEPARTMENT OF CONSERVATION  
FORESTRY DIVISION

# LAND CORNER RECORD

T. 28 N.R. 5 W


Kalkaska COUNTY

DESCRIPTION OF CORNER Sec. corner common to Sections: 26-27-34-35

CORNER MONUMENT Set Cons. Dept. Mon.

DATE MONUMENT PLACED AND WITNESSED 2/8/68

WITNESSES TO CORNER.....

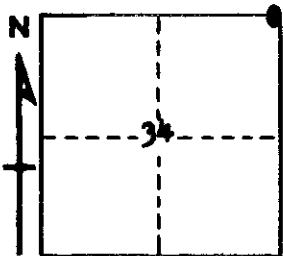

CIRCLE CORNER REGISTERED

5" R. Pine N 10 W 167.7


16" W. Pine S 75 W 107.3

AND

DESCRIPTION IN DETAIL AS TO HOW CORNER WAS LOCATED AND IDENTIFIED OR RESTORED.

This corner was set by double proportionate measurement during a retracement in this area. Could find no support for two other pipes located in vicinity, and felt a restoration by measurement provided a proper distribution of available land. Schaaf pipe removed and salvaged.

SURVEYOR'S SEAL

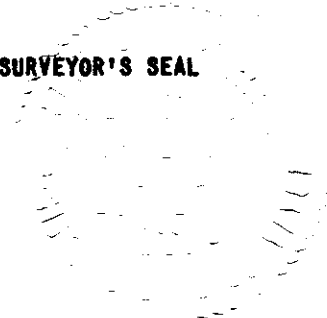

SIGNED *Kenneth J. DeLong* DATE 2/15/68  
REGISTERED LAND SURVEYOR #10068