LAND CORNER RECORDATION CERTIFICATE

Filing Requirement of Act 74, Mich. P.A. 1970

For corners in KALKASKA (County)

	Located In:	Corner Code ##
1. Public Land Survey	T 28N R 5W	C-1,C-2
	T ___ R ___	
	T ___ R ___	
	T ___ R ___	
2. Property Controlling	S 5 T ___ R ___	3
in Section	S ___ T ___ R ___	
3. Miscellaneous	S ___ T ___ R ___	
Property in Sec.	S ___ T ___ R ___	

Register of Deeds Stamp & File Number

4. Lot No. _____ , Recorded Plat _____
5. Private Claims _____

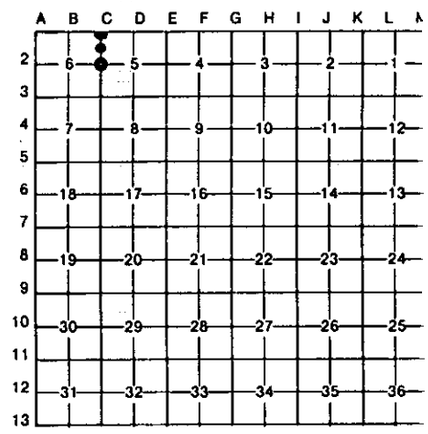

I, C.F.ROSER, in a field survey on MARCH,03, 19 89, do hereby certify that under requirements of P.A. 74, Michigan P.A. of 1970, the corner points mentioned in lines 1 and 2 above were in conformance with regulations and rules therefore as required in the current manual of survey instructions of the United States Department of the Interior, Bureau of Land Management or by a decree of a Court of Law and/or that the corner points mentioned in lines 3, 4 and 5 above were in conformance with the rules of the Michigan Board of Land Surveyors or by a Decree of a Court of Law; established, re-established, monumented, re-monumented, recovered, found as expressed below:

NOTE: Not more than 4 corners, all in the same town and range, may be recorded on this certificate.

~~A. Description of original monument and accessories and/or subsequent restoration:~~

C-1

PART B CONT.
N64°24'12"E, 318.11' FROM 1957 DEPT NW COR SEC 5.
REFERENCE'S: SEE SURVEY MAP, INCL MINUTES OF SURVEY, OF SEC 5, BY KJO(1969); AND SURVEY MAP, INCL SURVEY REPORT, CFR, MAR. 1989.

C-2

3

B. Description of corner evidence found and/or method applied in restoring or reestablishing corner:

C-1

FD CONS DEPT MON FOR SEC COR TO SEC'S 5 & 6(28-5) AS ESTABLISHED BY K.J.OSTLING IN 1957 DEPT SURVEY OF S1/2 OF T29N-R5W, ANTRIM CO. A POSS. CALC. POSITION FOR NW COR S-5, PER 1919 B.L.CAUKINS RETRACEMENT SURVEY THIS AREA, INCL. S-5 SUB'N,(NOTHING FD OR SET THIS SURVEY), WOULD BE

C-2

FD REROD IN B. TOP RD (1'± S. OF CTR) FOR N1/4 COR SEC 5. COR FITS B.L.CAUKINS 1919 SURVEY AND OTHER PREVIOUS SURVEYS OF RECORD IN SEC 5.

3

ESTABLISHED NW COR OF SW1/4 OF FRL NW1/4 OF SEC 5, AT PROPORTIONATE MEA. TO U.S. (G.L.O.- N1/2 OF N LINE SEC 5 EQUALS 40.00 CHAINS) BETWEEN FD N1/4 SEC 5 AND CALC POSITION FOR NW SEC 5, PER 1919 B.L.CAUKINS SURVEY & SEC SUB'N OF SEC 5. SEE LAND CORNER RECORDS C-1 AND C-2. CORNER FALLS IN RED PINE PLANTATION.

C. Description of monument for corner and accessories established to perpetuate locating the position of the corner:

C-1

FD CONS DEPT MON(BRASS CAP); ADDED CEDAR POST.

7" B.CHERRY	S30°E	14.1'
6" R.PINE	S10°E	72.5'
7" R.PINE	S45°W	61.0'
SW COR S-32(T29N-R5W) IS	S88°22'E	8.55'
CTR N-S TRAIL	WEST	17'

C-2

FD 1/2" REROD.

12" B.CHERRY	N23°W	36.55'
14" R.PINE	S03°W	43.62'
POWER POLE	S25°W	56.93'
SET CED POST W/LOC TAG	NORTH	33'

3

DROVE 5/8" X 34" REROD W/RLS CAP. SET CED POST W/ LOC TAG.

6" R.PINE	N15°W	3.8'
7" R.PINE	N65°E	5.8'
8" R.PINE	S10°E	5.4'
CTR N-S TRAIL	WEST	291'

STATE OF MICHIGAN
CARL F. ROSER
LAND SURVEYOR
No. 12028
REGISTERED LAND SURVEYOR

Signed by Carl F. Roser 03-30-90 Date _____

Surveyor's Michigan License No. 12028

FORM APPROVED BY MICHIGAN STATE BOARD OF LAND SURVEYORS, JAN. 28, 1971
REVISED MAY 14, 1975
REVISED JAN., 1983