

LAND CORNER RECORDATION CERTIFICATE

FILING REQUIREMENT OF ACT 74, MICH. P.A.1970

FOR CORNERS OF--:	LOCATED IN--:	CORNER CODE NUMBER
1. PUBLIC LAND SURVEY _____	T. <u>28</u> N. <u>•</u> , R. <u>5</u> W. <u>•</u>	<u>J-11</u> ; <u>J-12</u> ; <u>K-11</u>
2. PROPERTY CONTROLLING IN SECTION <u>35</u>	T. <u>28</u> N. <u>•</u> , R. <u>5</u> W. <u>•</u>	<u>11</u> ; <u>12</u>
3. MISCELLANEOUS PROPERTY IN SECTION _____	T. _____ N. _____, R. _____ E. _____ W. _____	_____
4. LOT NO. _____, RECORDED PLAT _____		
5. PRIVATE CLAIMS _____		

REGISTER OF DEEDS STAMP AND FILING NUMBER

I, Carl F. Roser, do hereby certify that under requirements of P.A. 74, Michigan P.A. of 1970, the corner points mentioned in lines 1 and 2 above were, in a field survey on Nov. 3, 1976, established, re-established, monumented, re-monumented, recovered or restored as expressed below and in conformance with regulations and rules therefore as required in the current manual of survey instructions of the United States Department of the Interior, Bureau of Land Management or by a decree of a court of law. Furthermore, that the corner points mentioned in lines 3, 4 and 5 above were, in a field survey on _____, 19____, found, recovered, restored, established or re-established as expressed below and in conformance with the rules of the Michigan State Board of Registration for Land Surveyors or, by a Decree of a Court of law:

	11	12
A. Description of original monument and accessories and/or subsequent restoration--		
C. (continued)	5/8" X 36" R. Rod Ced. post w/Loc. Tag. 8" Maple N43°E 10.6 8" Maple S88°E 30.1 8" Maple S64°W 27.5 7" Oak N45°W 22.5	Set 5/8" X 36" Re-rod & Ced. post w/Loc. Tag. 6" R. Pine N10°E 80.5 4" R. Pine S75°E 82.5 5" W. Pine N68°W 81.4 Ctr. of trail (NW-SE) Due W 42'+

- B. Description of corner evidence found and/or method applied in restoring or re-establishing corner:
- J-11 Recovered DNR Mon. from previous Dept. Survey (1969) which perpetuated M.Schaaf cor. Established in 1945 from U.S.B.T stump w/lower face.
 - J-12 Established ctr. of Sec. 25 at Inter. of 1/4 lines.
 - K-11 Recovered DNR Mon. from previous Dept. Survey of 1951 which perpetuated M.Schaaf Cor. as set from original B.T.'s sites.
 - 11 Established Ctr. of SW 1/4 S-35 per standard B.L.M. instructions.
 - 12 Established 1/8 Cor equadistant & on line between S 1/4 Cor. & Ctr. of S-35.

C. Description of monument for corner and accessories established to perpetuate locating the position of the corner:

	J-11	J-12		K-11
Fd. DNR Mon. & Ced. post		Set 3/4" X 48" R. Rod & Ced. post w/Loc. Tag		Fd. DNR Mon. Ced. post
14" W. Pine S09°W 88.9		20" R. Pine N82°W 71.3		6" R. Pine N26°W 95.9
14" Tamarack S36°W 68.2		20" R. Pine N42°E 95.1		8" R. Pine N53°E 128.8
10" W. Pine N32°E 54.6		4" R. Pine S07°W 24.6		6" R. Pine S73°E 136.3
5" W. Pine N58°E 59.8		5" R. Pine S47°E 48.1		16" Oak S85°W 114.0


SIGNED BY Carl F. Roser DATE 3-31-78

SURVEYOR'S MICHIGAN REGISTRATION NO. 12028

FOR STATE AND UNITED STATES AGENCIES:

SIGNED BY _____ DATE _____
CHIEF OF SURVEY PARTY

APPROVED AND SIGNED BY _____ DATE _____
MICHIGAN REGISTERED LAND SURVEYOR

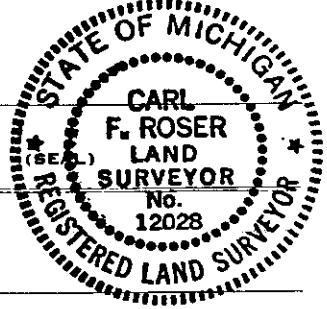

SURVEYOR'S MICHIGAN REGISTRATION NO. _____ BLUE LAKE TOWNSHIP
KALKASKA COUNTY