

LAND CORNER RECORDATION CERTIFICATE

FILING REQUIREMENT OF ACT 74, MICH. P.A.1970

FOR CORNERS OF--:	LOCATED IN--:	CORNER CODE NUMBER
1. PUBLIC LAND SURVEY _____ T. <u>28</u> N. <u>5</u> W.		I-8; K-8; <u>K-9</u>
2. PROPERTY CONTROLLING IN SECTION _____, T. _____ N. _____ S., R. _____ E. _____ W.		
3. MISCELLANEOUS PROPERTY IN SECTION _____, T. _____ N. _____ S., R. _____ E. _____ W.		
4. LOT NO. _____, RECORDED PLAT _____		
5. PRIVATE CLAIMS _____		

REGISTER OF DEEDS STAMP AND FILING NUMBER

I, Corey J. Hughes, do hereby certify that under requirements of P.A. 74, Michigan P.A. of 1970, the corner points mentioned in lines 1 and 2 above were, in a field survey on July 29, 1976, established, re-established, monumented, re-monumented, recovered or restored as expressed below and in conformance with regulations and rules therefore as required in the current manual of survey instructions of the United States Department of the Interior, Bureau of Land Management or by a decree of a court of law. Furthermore, that the corner points mentioned in lines 3, 4 and 5 above were, in a field survey on _____, 19____, found, recovered, restored, established or re-established as expressed below and in conformance with the rules of the Michigan State Board of Registration for Land Surveyors or, by a Decree of a Court of law:

A. Description of original monument and accessories and/or subsequent restoration:

B. Description of corner evidence found and/or method applied in restoring or re-establishing corner:

- I-8 Found corner as platted & locally accepted as the W $\frac{1}{4}$. Set cedar post & tag.
- K-8 Found pipe in concrete set by Marcus Schaaf, RLS, from original B.T.'s. Replaced with DNR monument.
- K-9 Recovered Dept. monument as set 3-9-51 from Marcus Schaaf data. Schaaf notes dated 4-5-46 indicate he re-established the Sec. Cor, 23-24-25-26 at double the distance across the $\frac{1}{2}$ Cor. & Sec. Cor. to east and on line across U.S.L.T. (stump) $\frac{1}{4}$ mile east and $\frac{1}{2}$ Cor. to east.

C. Description of monument for corner and accessories established to perpetuate locating the position of the corner:

I-8	K-8	K-9
Fd. 4" concrete monument	Set DNR mon. & cedar post	Found Dept. Mon. & Set cedar post
10" Maple N78°W 44.6	4" Maple N89°W 24.9	10"W. Pine S70°W 25.1
10" Aspen N10°W 9.5	6" Maple N37°E 39.0	Fd. 16" R.Pine Stp
5" Maple in clump	6" Twin Maple S51°E 20.1	S23°E 132.7±
S61°E 22.9		Fd. 26" W.Pine S51°W 148.5
Center of Bass Lake Road		Trail Rd. N-S 142'± East
28.5' South		10" R. Pine N49°E 42.2
5" Maple N37°E 34.2		8" R. Pine S11°E 20.4
Fd. Angle Iron 4' West		


SIGNED BY _____ DATE _____

SURVEYOR'S MICHIGAN REGISTRATION NO. _____

FOR STATE AND UNITED STATES AGENCIES:
Above corners by Corey J. Hughes, R.L.S. #20706; Title X

Survey for Mich. D.N.R., Summer, 1976
SIGNED BY _____ DATE _____

APPROVED AND SIGNED BY Carl F. Roser 1-13-78 DATE _____
Carl F. Roser
MICHIGAN REGISTERED LAND SURVEYOR

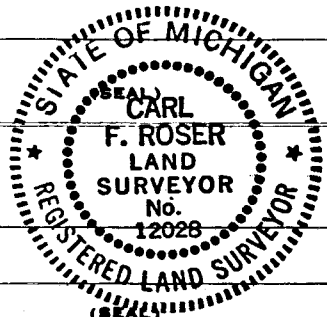

SURVEYOR'S MICHIGAN REGISTRATION NO. 12028

BLUE LAKE TOWNSHIP
KALKASKA COUNTY