LAND CORNER RECORDATION CERTIFICATE

Filing Requirement of Act 74, Mich. P.A. 1970

For corners in KALKASKA (County)

	Located In:	Corner Code ##
1. Public Land Survey	T 28N R 5W	D-3,E-3
	T ___ R ___	
	T ___ R ___	
	T ___ R ___	
2. Property Controlling	S 5 T ___ R ___	14,16
in Section	S ___ T ___ R ___	
3. Miscellaneous	S ___ T ___ R ___	
Property in Sec.	S ___ T ___ R ___	

Register of Deeds Stamp & File Number

4. Lot No. _____ , Recorded Plat _____
5. Private Claims _____

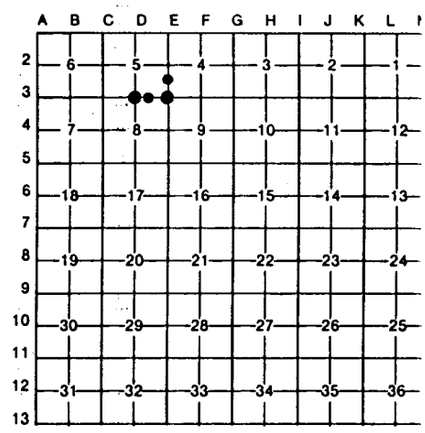

I, C.F.ROSER, in a field survey on MARCH,17, 19 89, do hereby certify that under requirements of P.A. 74, Michigan P.A. of 1970, the corner points mentioned in lines 1 and 2 above were in conformance with regulations and rules therefore as required in the current manual of survey instructions of the United States Department of the Interior, Bureau of Land Management or by a decree of a Court of Law and/or that the corner points mentioned in lines 3, 4 and 5 above were in conformance with the rules of the Michigan Board of Land Surveyors or by a Decree of a Court of Law; established, re-established, monumented, re-monumented, recovered, found as expressed below:

NOTE: Not more than 4 corners, all in the same town and range, may be recorded on this certificate.

A. Description of original monument and accessories and/or subsequent restoration:

D-3 E-3 14 16

B. Description of corner evidence found and/or method applied in restoring or reestablishing corner:

D-3	E-3	14	16
FD. 4" SQUARE CONC MON (CORNERS CHAMFERED) FOR S1/4 COR SEC 5. MON FITS B.L.CAUKINS 1919 SURVEY AND WAS ACCEPTED IN 1969 DEPT. SURVEY.	FD. DEPT MON FOR SE COR SEC 5, AS RESTORED IN 1969 SURVEY BY K.J.OSTLING (CORNER WAS RESTORED ACCORDING TO B.L.CAUKINS 1919 SURVEY).	ESTABLISHED SE COR OF NE 1/4-SE 1/4 OF SEC 5 EQUIDISTANT AND ON LINE BETWEEN SE COR AND E 1/4 COR OF SEC 5; SAID CONTROLLING CORNERS BEING PER 1919 B.L.CAUKINS SURVEY AND SEC SUB'N. OF SEC 5.	ESTABLISHED SE COR OF SW 1/4 OF SE 1/4 OF SEC 5, M.O.L. BETWEEN SE AND S 1/4 COR'S OF S-5; FITS B.L.CAUKINS 1919 SURVEY (COULD NOT FIND B.L.CAUKINS 1/8 POST OR WIT'S). FD NEW 5/8" ROD, PAINTED RED, DUE SOUTH 70'.

C. Description of monument for corner and accessories established to perpetuate locating the position of the corner:

D-3	E-3	14	16
FD. CONC MON W/1/2" REROD; ADDED CED POST W/LOC. TAG.	FD. CONS. DEPT. MON; ADDED CEDAR POST.	DROVE 5/8" X 34" REROD W/RLS CAP AND SET CED POST W/LOC TAG.	DROVE 5/8" X 34" REROD W/RLS CAP, SET CED. POST W/LOC. TAG.
*11" B.CHERRY N30°W 46.16'	*10"MAPLE(CLP 4) N81°W 19.2'	6"S.MAPLE(CLP 2) DUE E. 8.2'	6" MAPLE S70°W 11.4'
*10" B.CHERRY S50°E 16.66'	*9"MAPLE(CLP 3) N43°E 31.68'	6"S.MAPLLE(CLP 4) SE 24.8'	4"S.MAPLE N75°E 14.9'
*8" W.PINE S03°E 44.85'	5"S.MAPLE S40°E 3.9'	CTR N-S WINDING TRAIL	9" TWIN MAPLE S10°E 7.1'
4" R.PINE N80°W 8.71'	*7"S.MAPLE S13°E 12.2'	IS WEST 20'	CTR TRAIL N'LY WEST 69'
CTR E-W RR GRADE SOUTH 180'	CTR E-W RR GRADE SOUTH 36'		CTR E-W RR GRADE SOUTH 99'
	CTR N-S TRAIL EAST 127'		

* = RLS JIM STEPHENS,#16053 BT

Signed by Carl F. Roser 03-30-90 Date _____

Surveyor's Michigan License No. 12028

FORM APPROVED BY MICHIGAN STATE BOARD OF LAND SURVEYORS JAN. 28, 1972 REVISED MAY 24, 1974 REVISED JUNE 1982

STATE OF MICHIGAN CARL F. ROSER LAND SURVEYOR NO. 12028 REGISTERED LAND SURVEYOR