

FEB 14 1997

**KENT COUNTY REMONUMENTATION
LAND CORNER RECORDATION CERTIFICATE
Filing Requirement of Act 74, Mich. P.A. 1970**

For corners in

Kent
(County)

Located In: Bowen Twp.
Corner Code #

1. Public Land Survey	T <u>5</u> N	R <u>9</u> W	B-2
	T	R	Gen. of Sec. 6
	T	R	
	T	R	
2. Property Controlling in Section	S	T	R
	S	T	R
3. Miscellaneous Property in Sec.	S	T	R
	S	T	R

STATE OF MICHIGAN
 COUNTY OF KENT
 RECEIVED FOR RECORD
 96 DEC 18 PM 1:17
 REG. OF DEEDS
Lucy Bond
9596
 Register of Deeds Stamp & File Number

4. Lot No. _____, Recorded Plat _____
 5. Private Claims _____

I, Robert Jonker, in a field survey on 8-3, 1996 do hereby state that under requirements of P.A. 74, Michigan P.A. of 1970, the corner points mentioned in lines 1 and 2 above were in conformance with regulations and rules therefore as required in the current manual of survey instructions of the United States Department of the Interior, Bureau of Land Management or by a decree of a Court of Law and /or that the corner points mentioned in lines 3, 4 and 5 above were in conformance with the rules of the Michigan Board of Land Surveyors or by a Decree of a Court of Law; established, re-established, monumented, recovered, found as expressed below:

NOTE: Not more than 2 corners, all in the same town and range, may be recorded on this certificate.

1	A	B	C	D	E	F	G	H	I	J	K	L	M
2	●			5		4		3		2		1	
3													
4	7		8		9		10		11		12		
5													
6	18		17		16		15		14		13		
7													
8	19		20		21		22		23		24		
9													
10	30		29		28		27		26		25		
11													
12	31		32		33		34		35		36		
13													

A. Description of original monument and accessories and/or subsequent restoration:

Not set in GLO survey
 No wit. on county wit. map

LCRC #1260, 1979, Exxel Eng.
 Set capped iron @ int. of 1/4 lines, took wit.
 Spk - side 22" Oak W 6.77'
 Spk - side 20" Oak SW 15.41'
 Spk - side 20" Tw. Oak NE 13.75'
 N-S fence 6'± East
 E-W fence line 2'± North

B. Description of corner evidence found and/or method applied in restoring or reestablishing corner:

Found Exxel capped iron by witnesses listed in "A" for LCRC #1260

P.A. 345 1990 KENT COUNTY
 PEER APPROVED 4/4/96
 CHAIRMAN Harry Hubert


Accepted as the best available evidence of the position of the corner.

Approved by the Kent County Peer Group on April 4, 1996.

C. Description of monument for corner and accessories established to perpetuate locating the position of the corner:

Replaced with 4" standard Kent county monument in field (Harrison)

Found nail - S. side 26" stump N 83° W 6.38'
 Remon N & T- W. side 36" Oak S 2° E 51.64'
 Remon N & T- N. side 45" Oak N 83° E 14.31'
 Remon N & T- E. side 10" W. Cherry N 10° W 7.47'

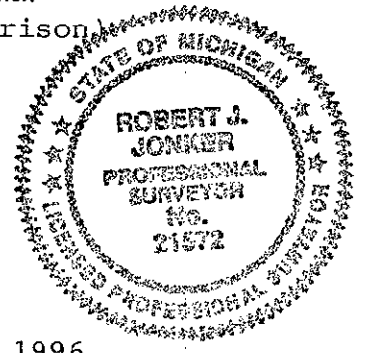

Signed by Robert J. Jonker
 Surveyor's Michigan License No. 21572

Date August 03, 1996