

**SURVEY & REMONUMENTATION**

MAR 03 1998

KENT COUNTY REMONUMENTATION

**LAND CORNER RECORDATION CERTIFICATE**  
Filing Requirement of Act 74, Mich. P.A. 1970

For corners in SECTION  
KENT COUNTY  
(County)

| Located In:                              | Corner Code # |
|--|---------------|
| 1. Public Land Survey T5N R9W            | B-3           |
| T R                                      |               |
| T R                                      |               |
| T R                                      |               |
| 2. Property Controlling in Section S T R |               |
| S T R                                    |               |
| 3. Miscellaneous Property in Sec. S T R  |               |
| S T R                                    |               |

STATE OF MICHIGAN  
COUNTY OF KENT  
RECEIVED FOR RECORD  
97 APR 29 AM 8:17  
REG. OF DEEDS  
*W. J. [Signature]*

9706

Register of Deeds Stamp & File Number

4. Lot No. \_\_\_\_\_, Recorded Plat \_\_\_\_\_  
5. Private Claims \_\_\_\_\_

I, Kirk Breitels, in a field survey on Jan. 17, 1997 do hereby state that under requirements of P.A. 74, Michigan P.A. of 1970, the corner points mentioned in lines 1 and 2 above were in conformance with regulations and rules therefore as required in the current manual of survey instructions of the United States Department of the Interior, Bureau of Land Management or by a decree of a Court of Law and/or that the corner points mentioned in lines 3, 4 and 5 above were in conformance with the rules of the Michigan Board of Land Surveyors or by a Decree of a Court of Law; established, re-established, monumented, recovered, found as expressed below:

NOTE: Not more than 2 corners, all in the same town and range, may be recorded on this certificate.

|    |    |   |    |   |    |   |    |   |    |   |    |   |   |
|----|----|---|----|---|----|---|----|---|----|---|----|---|---|
|    | A  | B | C  | D | E  | F | G  | H | I  | J | K  | L | M |
| 1  |    |   |    |   |    |   |    |   |    |   |    |   |   |
| 2  | 6  |   | 5  |   | 4  |   | 3  |   | 2  |   | 1  |   |   |
| 3  |    |   |    |   |    |   |    |   |    |   |    |   |   |
| 4  | 7  |   | 8  |   | 9  |   | 10 |   | 11 |   | 12 |   |   |
| 5  |    |   |    |   |    |   |    |   |    |   |    |   |   |
| 6  | 18 |   | 17 |   | 16 |   | 15 |   | 14 |   | 13 |   |   |
| 7  |    |   |    |   |    |   |    |   |    |   |    |   |   |
| 8  | 19 |   | 20 |   | 21 |   | 22 |   | 23 |   | 24 |   |   |
| 9  |    |   |    |   |    |   |    |   |    |   |    |   |   |
| 10 | 30 |   | 29 |   | 28 |   | 27 |   | 26 |   | 25 |   |   |
| 11 |    |   |    |   |    |   |    |   |    |   |    |   |   |
| 12 | 31 |   | 32 |   | 33 |   | 34 |   | 35 |   | 36 |   |   |
| 13 |    |   |    |   |    |   |    |   |    |   |    |   |   |

A. Description of original monument and accessories and/or subsequent restoration:

|     |      |            |         |                                      |
|-----|------|------------|---------|--------------------------------------|
| B-3 | 1830 | GLO        | Mullett | Set Post                             |
|     | 1974 | LCRC #704  | Bonnema | "T" Iron                             |
|     | 1976 | LCRC #968  | Ankrom  | "T" Iron                             |
|     | 1982 | LCRC #2664 | Bonnema | Set Kent County Monument in Mon. Box |
|     | 1990 | LCRC #5332 | Starr   | Kent County Monument                 |

The position of this corner was previously approved by the Kent County Remonumentation Peer Group, monumented by Douglas W. Bonnema on 2/19/82 and was recorded per LCRC #2664

B. Description of corner evidence found and/or method applied in restoring or reestablishing corner:


B-3 Found standard Kent Co. Mon. (Harrison) per witnesses from above LCRC as set by Douglas W. Bonnema in place of the "T" Iron he found inside a Mon. Box. Said "T" Iron checks with LCRC's #704 & #968.

| LCRC #2664                           | LCRC #5332                              |
|--------------------------------------|---|
| Nail & tag 16" Oak N15°W 37.88'      | Nail & tag 26" Oak N14°W 37.77'         |
| Nail & tag 26" Poplar N30°E 137.62'  | Nail & tag 40" Poplar N30°E 137.69'     |
| Nail & tag 28" Oak N70°E 103.33'     | Nail & tag 32" Oak N70°E 103.38'        |
| Nail & tag 6" Poplar S60°E 68.65'    | Nail & tag dbl. 14" Poplar S58°E 68.72' |
| Nail & tag tri. 12" Ash S05°W 44.90' | Nail & tag tri. 14" Ash S01°W 44.95'    |

The selected location is accepted by me and is generally accepted by professional surveyors as the best available evidence of the position of the original corner.

C. Description of monument for corner and accessories established to perpetuate locating the position of the corner:

|   |               |
|---|---------------|
| B-3 Standard Kent County Monument in Mon. Box |               |
| Nail & KC Remon. tag E. side 30" Oak          | N14°W 37.82'  |
| Nail & KC Remon. tag W. side Tri. 24" Poplar  | N30°E 137.69' |
| Nail & KC Remon. tag SE side 38" Oak          | N70°E 103.43' |
| Nail & KC Remon. tag SW side DbL. 18" Poplar  | S58°E 68.66'  |
| Nail & KC Remon. tag W. side Tri. 14" Ash     | S01°W 44.95'  |
| Corner is on fence & tree lines to N & S      |               |
| Corner is on C/L 68th St. (blacktop)          |               |

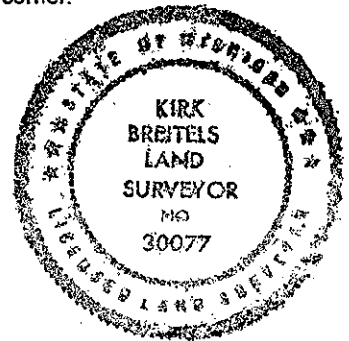

Signed by *Kirk Breitels*  
Surveyor's Michigan License No. 30077

Date 3/27/97

P.A. 345-1990 KENT COUNTY,  
PEER APPROVED 3/27/97  
CHAIRMAN *[Signature]*