

**SURVEY & REMONUMENTATION**

MAR 03 1998

**KENT COUNTY REMONUMENTATION**

**SECTION**

**LAND CORNER RECORDATION CERTIFICATE**  
Filing Requirement of Act 74, Mich. P.A. 1970

For corners in  
**KENT COUNTY**

(County)

Located In: Corner Code #

- |                                    |                         |       |
|------------------------------------|-------------------------|-------|
| 1. Public Land Survey              | T 5N R 9W               | B-12  |
|                                    | T _____ R _____         | _____ |
|                                    | T _____ R _____         | _____ |
|                                    | T _____ R _____         | _____ |
| 2. Property Controlling in Section | S _____ T _____ R _____ | _____ |
|                                    | S _____ T _____ R _____ | _____ |
| 3. Miscellaneous Property in Sec.  | S _____ T _____ R _____ | _____ |
|                                    | S _____ T _____ R _____ | _____ |

REG. OF DEEDS

*Luci Bond*

97 OCT 14 AM 10:01

STATE OF MICHIGAN  
COUNTY OF KENT  
RECEIVED FOR RECORD

**10021**

Register of Deeds Stamp & File Number

4. Lot No. \_\_\_\_\_, Recorded Plat \_\_\_\_\_  
5. Private Claims \_\_\_\_\_

I, Kirk Breitels, in a field survey on June 13, 1997 do hereby state that under requirements of P.A. 74, Michigan P.A. of 1970, the corner points mentioned in lines 1 and 2 above were in conformance with regulations and rules therefore as required in the current manual of survey instructions of the United States Department of the Interior, Bureau of Land Management or by a decree of a Court of Law and /or that the corner points mentioned in lines 3, 4 and 5 above were in conformance with the rules of the Michigan Board of Land Surveyors or by a Decree of a Court of Law; established, re-established, monumented, recovered, found as expressed below:

NOTE: Not more than 2 corners, all in the same town and range, may be recorded on this certificate.

	A	B	C	D	E	F	G	H	I	J	K	L	M
1													
2		6		5		4		3		2		1	
3													
4		7		8		9		10		11		12	
5													
6		18		17		16		15		14		13	
7													
8		19		20		21		22		23		24	
9													
10		30		29		28		27		26		25	
11													
12		31		32		33		34		35		36	
13													

A. Description of original monument and accessories and/or subsequent restoration:

- B-12 1830---GLO---Not Set  
Williams & Works---No information  
Kent Co. Wits.---No information  
1980---LCRC #1346---Bonnema---Set Capped Iron at intersection of 1/4 lines  
Spike in 14" Maple SE 2.35' Spike in 12" Maple East 37.25'  
Spike in 30" Maple North 36.70' Spike in 10" Cherry West 33.67'  
E-W fence North 5.5' N-S fence West 8'

B. Description of corner evidence found and/or method applied in restoring or reestablishing corner:


- B-12 Found Capped Rerod (Exxel) per the following witnesses:  
Fd. spike in NE side 18" Maple S40°E 2.33'  
Fd. spike in N. side 16" Maple East 37.25'  
Fd. spike in W. side 30" Stump North 36.70'  
Fd. spike in S. side 10" Cherry West 33.67'  
Fc. corner for fences N-E is 10' West & 5.5' North

Capped Rerod is 0.2' E. and 0.5' N. from intersection of 1/4 lines.

The Capped Rerod is accepted by me and is generally accepted by professional surveyors as the best available evidence of the position of the corner.

C. Description of monument for corner and accessories established to perpetuate locating the position of the corner:

- B-12 Set Standard Kent Co. Monument (Harrison) in place of the Capped Rerod.  
Spike in NE side 18" Maple S45°E 2.33'  
Spike in N. side 16" Maple East 37.25'  
Spike in W. side 30" Stump North 36.70'  
Spike in S. side 10" Cherry N75°W 33.67'  
Fc. corner for fences N-E is 10' West & 5.5' North

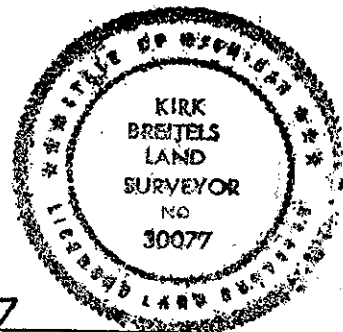

Signed by *Kirk Breitels*  
Surveyor's Michigan License No. 30077

Date 8/28/97

P.A. 345 1990 KENT COUNTY

PEER APPROVED 7/24/97

CHAIRMAN *Harry Thubert*