

SURVEY & REMONUMENTATION

MAR 03 1998

KENT COUNTY REMONUMENTATION

LAND CORNER RECORDATION CERTIFICATE
Filing Requirement of Act 74, Mich. P.A. 1970

SECTION
For corners in
KENT COUNTY

(County)	Located In:	Corner Code #
1. Public Land Survey	T 5N R 9W	B-13
	T R	
	T R	
	T R	
	T R	
2. Property Controlling in Section	S T R	
	S T R	
3. Miscellaneous Property in Sec.	S T R	
	S T R	

STATE OF MICHIGAN
COUNTY OF KENT
RECEIVED FOR RECORD

97 APR 29 AM 8:17

REG. OF DEEDS

Luis J. Bond

9710

Register of Deeds Stamp & File Number

4. Lot No. _____, Recorded Plat _____
5. Private Claims _____

I, Kirk Breitels, in a field survey on Feb. 28, 1997 do hereby state that under requirements of P.A. 74, Michigan P.A. of 1970, the corner points mentioned in lines 1 and 2 above were in conformance with regulations and rules therefore as required in the current manual of survey instructions of the United States Department of the Interior, Bureau of Land Management or by a decree of a Court of Law and/or that the corner points mentioned in lines 3, 4 and 5 above were in conformance with the rules of the Michigan Board of Land Surveyors or by a Decree of a Court of Law; established, re-established, monumented, recovered, found as expressed below:

NOTE: Not more than 2 corners, all in the same town and range, may be recorded on this certificate.

	A	B	C	D	E	F	G	H	I	J	K	L	M
1													
2	6		5		4		3		2		1		
3													
4	7		8		9		10		11		12		
5													
6	18		17		16		15		14		13		
7													
8	19		20		21		22		23		24		
9													
10	30		29		28		27		26		25		
11													
12	31		32		33		34		35		36		
13													

A. Description of original monument and accessories and/or subsequent restoration:

Date	Monument	Location	Material
B-13 1830	GLO	Mullett	Set Post
1968	Kent Co. Wit.		"T" Iron
1980	LCRC #1346	Bonnema	"T" Iron
1981	LCRC #1714	Merdzinski	Set Kent County Monument
1990	LCRC #5337	Starr	Kent County Monument

The position of this corner was previously approved by the Kent County Remonumentation Peer Group, monumented by John A. Merdzinski on 2/18/81 and was recorded per LCRC #1714

B. Description of corner evidence found and/or method applied in restoring or reestablishing corner:


B-13 Found standard Kent Co. Mon. (Harrison) per witnesses from above LCRC as set by John A. Merdzinski in place of the "T" Iron he found in a ring of stones. Said "T" Iron checks with Kent Co. Wit. and LCRC #1346.

LCRC #1714	LCRC #5337
Nail & tag 21" Oak S80°E 35.35'	Nail & tag 16" Oak N02°W 20.78'
Nail & tag 14" Walnut S30°W 32.20'	Nail & tag dbl. 4" 10" Maple N32°E 38.94'
Nail & tag 13" Tw. Maple S75°W 62.70'	Nail & tag 22" Oak S52°E 35.17'
Nail & tag 17" Maple N54°W 30.11'	Nail & tag 15" Walnut S31°W 32.20'
Nail & tag 15" Oak N10°W 20.69'	Nail & tag 16" Maple N54°W 30.87'
Nail & tag clump Birch N75°E 65.86'	Capped Rerod (Exxel) North 33.00'
Iron - W 14.46 Capped Iron - N 33.06'	1/2" Rerod West 14.51'

The selected location is accepted by me and is generally accepted by professional surveyors as the best available evidence of the position of the original corner.

C. Description of monument for corner and accessories established to perpetuate locating the position of the corner:

Monument	Direction	Distance
B-13 Standard Kent County Monument		
Nail & KC Remon. tag W. side 20" Oak	N02°W	20.78'
Nail & KC Remon. tag NW side dbl. 4" -10" Maple	N32°E	38.97'
Nail & KC Remon. tag SW side 26" Oak	S52°E	35.14'
Nail & KC Remon. tag SE side 18" Walnut	S31°W	32.25'
Capped Rerod (Exxel)	North	33.00'
1/2" Rerod	West	14.51'
On C/L E-W gravel road		

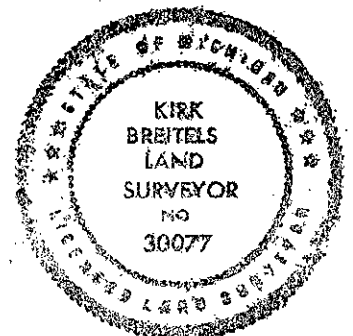

Signed by *Kirk Breitels*
Surveyor's Michigan License No. 30077

Date 3/27/97

P.A. 345 1990 KENT COUNTY
PEER APPROVED 3/27/97
CHAIRMAN *Harry Hubert*