

# SURVEY & REMONUMENTATION

MAR 03 1998

KENT COUNTY REMONUMENTATION

## SECTION

### LAND CORNER RECORDATION CERTIFICATE Filing Requirement of Act 74, Mich. P.A. 1970

For corners in  
KENT COUNTY  
(County)

	Located In:	Corner Code #
1. Public Land Survey	T 5N R 9W	C-2
	T _____ R _____	_____
	T _____ R _____	_____
	T _____ R _____	_____
2. Property Controlling in Section	S _____ T _____ R _____	_____
	S _____ T _____ R _____	_____
3. Miscellaneous Property in Sec.	S _____ T _____ R _____	_____
	S _____ T _____ R _____	_____

STATE OF MICHIGAN  
COUNTY OF KENT  
RECEIVED FOR RECORD

97 APR 29 AM 8:17

REG. OF DEEDS


9712

Register of Deeds Stamp & File Number

4. Lot No. \_\_\_\_\_, Recorded Plat \_\_\_\_\_  
5. Private Claims \_\_\_\_\_

I, Kirk Breitels, in a field survey on Jan. 17, 1997 do hereby state that under requirements of P.A. 74, Michigan P.A. of 1970, the corner points mentioned in lines 1 and 2 above were in conformance with regulations and rules therefore as required in the current manual of survey instructions of the United States Department of the Interior, Bureau of Land Management or by a decree of a Court of Law and /or that the corner points mentioned in lines 3, 4 and 5 above were in conformance with the rules of the Michigan Board of Land Surveyors or by a Decree of a Court of Law; established, re-established, monumented, recovered, found as expressed below:

NOTE: Not more than 2 corners, all in the same town and range, may be recorded on this certificate.

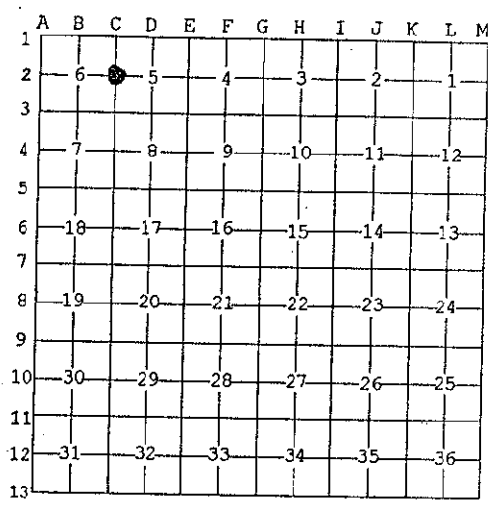

- A. Description of original monument and accessories and/or subsequent restoration:
- |     |      |               |         |                                      |
|-----|------|---------------|---------|--------------------------------------|
| C-2 | 1830 | GLO           | Mullett | Set Post                             |
|     | 1963 | Kent Co. Wit. |         | 3/4" Iron                            |
|     | 1974 | LCRC #704     | Bonnema | 3/4" Iron with Sq. Spike             |
|     | 1976 | LCRC #968     | Ankrom  | Boat Spike                           |
|     | 1982 | LCRC #2662    | Bonnema | Set Kent County Monument in Mon. Box |
|     | 1990 | LCRC #5338    | Starr   | Kent County Monument                 |

The position of this corner was previously approved by the Kent County Remonumentation Peer Group, monumented by Douglas W. Bonnema on 2/19/82 and was recorded per LCRC #2662

- B. Description of corner evidence found and/or method applied in restoring or reestablishing corner:
- C-2 Found standard Kent Co. Mon. (Harrison) per witnesses from above LCRC as set by Douglas W. Bonnema in place of the 3/4" Iron he found inside a Mon. Box. Said Iron checks with Kent Co. Wits. and LCRC's #704 & #968.

<u>LCRC #2662</u>	<u>LCRC #5338</u>
Nail & tag Tw. 15" Ash S10°W 149.28'	Nail & tag fence post S41°W 43.99'
Nail & tag 14" Oak S75°W 77.08'	Nail & tag Tw. 18" Ash S16°W 149.28'
Nail & tag 14" Oak N35°W 140.97'	Nail & tag 16" Oak S75°W 77.10'
Nail & tag fence post S90°E 32.98'	Nail & tag 16" Oak N27°W 141.14'
"T" Iron West 33.0'	Nail & tag fence post S88°E 33.01'

The selected location is accepted by me and is generally accepted by professional surveyors as the best available evidence of the position of the original corner.

- C. Description of monument for corner and accessories established to perpetuate locating the position of the corner:

C-2 Standard Kent County Monument in Mon. Box	
Nail & KC Remon. tag W. side corner fence post	S41°W 43.99'
Nail & KC Remon. tag E. side Twin 22 Ash	S16°W 149.31'
Nail & KC Remon. tag N. side 18" Oak	S75°W 77.10'
Nail & KC Remon. tag NE side 18" Oak	N27°W 140.88'
Nail & KC Remon. tag S. side corner fence post	S88°E 33.10'
"T" Iron	West 33.03'
C/L blacktop road is West 0.5'±	



Signed by Kirk Breitels  
Surveyor's Michigan License No. 30077

Date 3/27/97

P.A. 345 1990 KENT COUNTY  
PEER APPROVED 3/27/97  
CHAIRMAN Starr Hubert